


44115  
4115

Sec. 15

Sec. 10

Sec. 10

Sec. 3

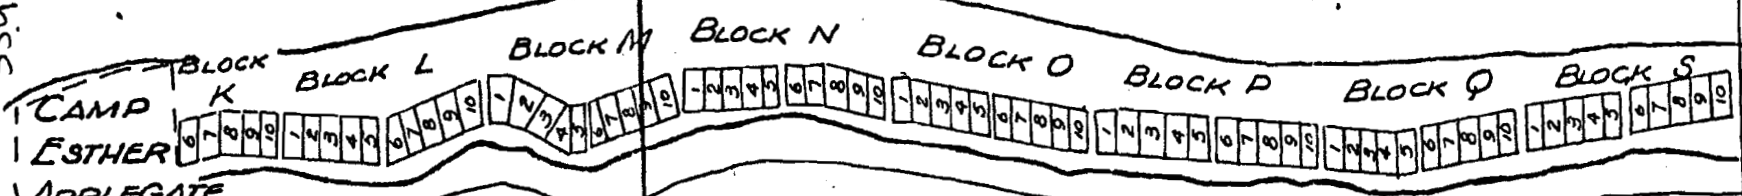

CAMP ESTHER  
 APPLEGATE  
 CAMP FIRE GIRLS  
 OF AMERICA

**RECEIVED**  
*Schwartz - E 7*


Application No. 58456  
 Permit No. 44115

MAY 01 1979

WATER RESOURCES DEPT.  
 SALEM, OREGON

LAKE OF THE WOODS

175 approximately  
 920'

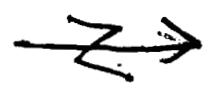

**RECEIVED**

MAR 27 1979

WATER RESOURCES DEPT.  
 SALEM, OREGON

Point of  
 Diversion

1173 ft. S. and 117 ft. E.  
 of the west W. corner of  
 Sec. 15, T. 37S, R. 5E, W.M


LAKE OF THE WOODS  
 RESORT

WHITE PINE  
 PICNIC AREA

RAINBOW  
 BAY

SUNSET  
 CAMPGROUND

INDIAN

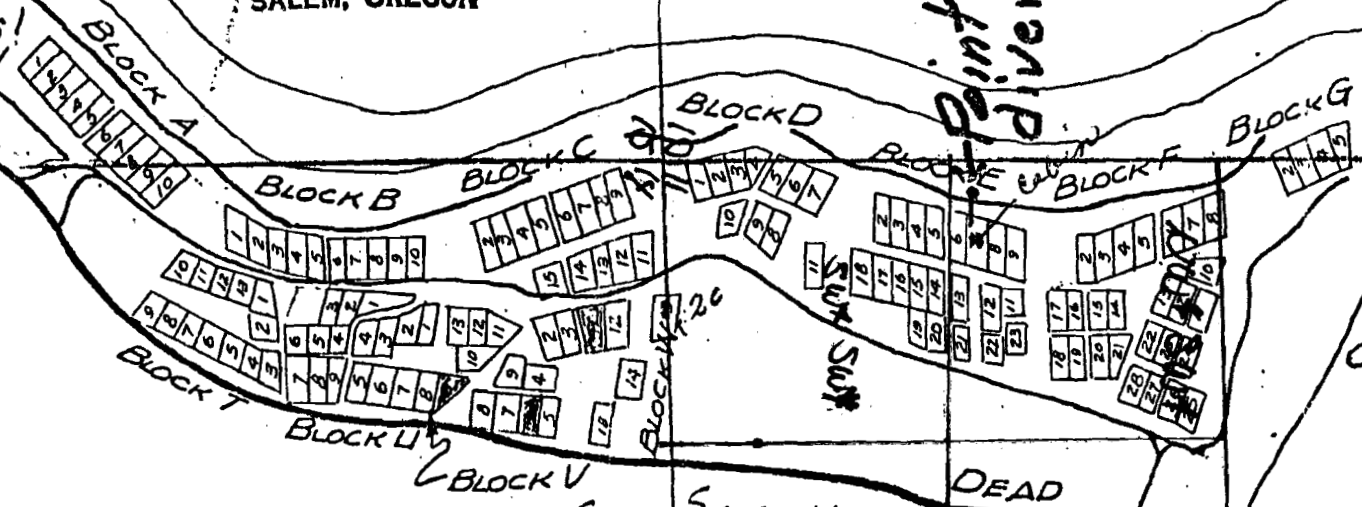

Sec. 14

Sec. 11

Sec. 11

Sec. 2

Journal in Mac