


5533
5533

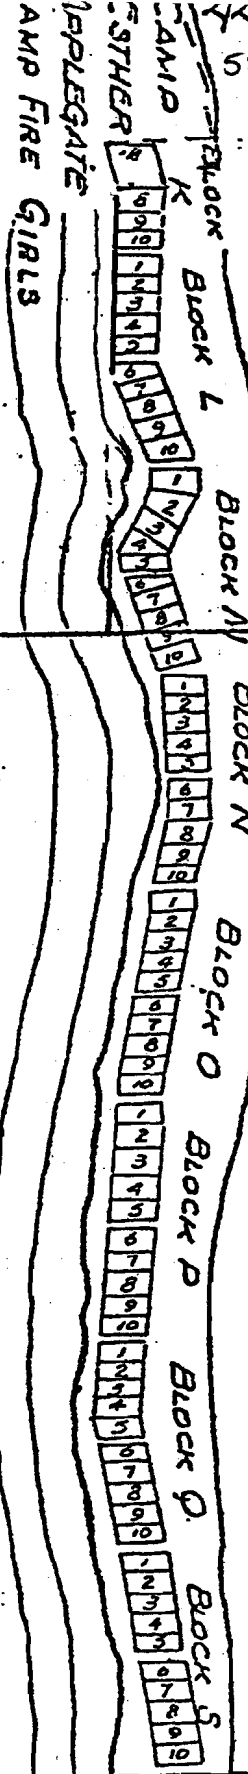

AMERICA
RECEIVED

AUG 15 1979

WATER RESOURCES DEPT
SALEM, OREGON

Application No. 59222
Permit No. 44535


RECEIVED

NOV - 5 1979

WATER RESOURCES DEPT
SALEM, OREGON

LAKE OF THE WOODS

POINT OF DIVERSION - 1549' S X 172' E OF
THE NE CORNER OF SEC 15, T37S, R5E.
POINT OF USE - REG RES IN LOT 7, BLD B,
LAKE OF THE WOODS SUMMER HOME TRACT

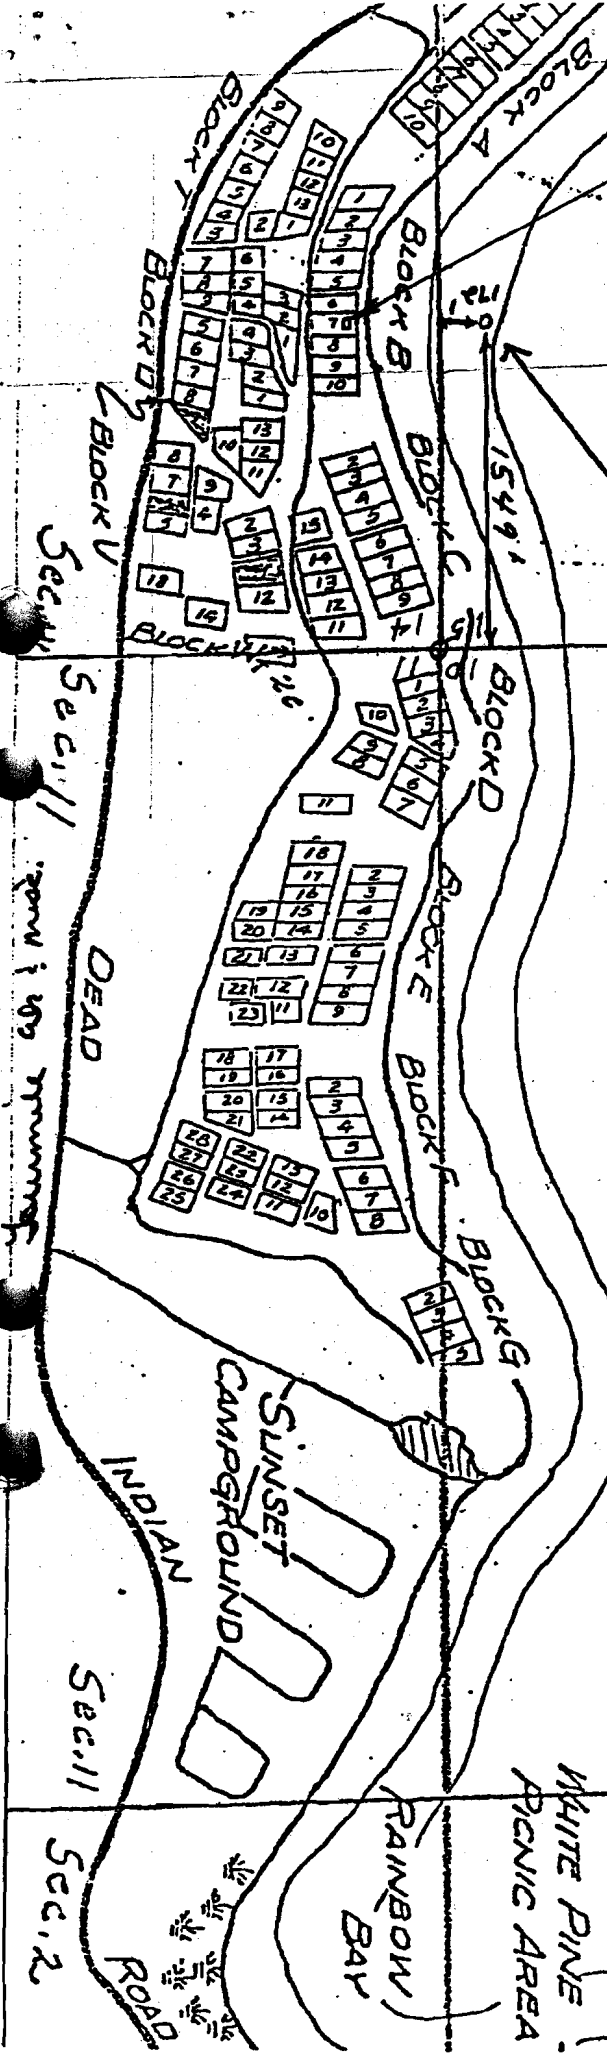

Sec 11
Sec 12
ROAD