


G-5333
55935.

T.40S.,R.19E.,W.M.

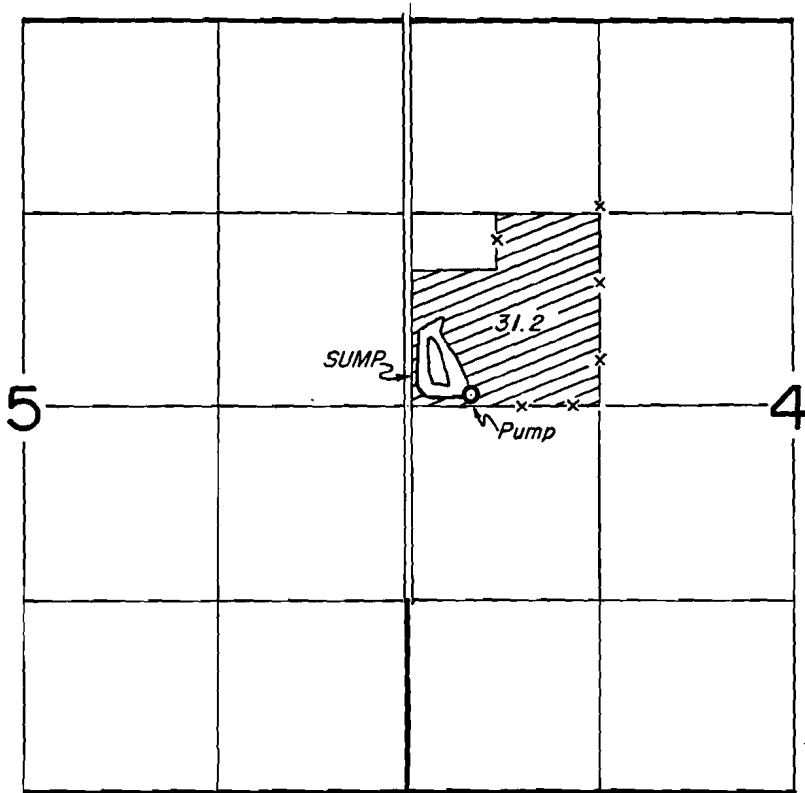

FINAL PROOF SURVEY UNDER

Application No. G-6592 Permit No. G-5333
IN NAME OF

J. R. STEWART

Surveyed OCT. 13, 1979, by *A. Brown*