


T.17S.R.1E.W.M.

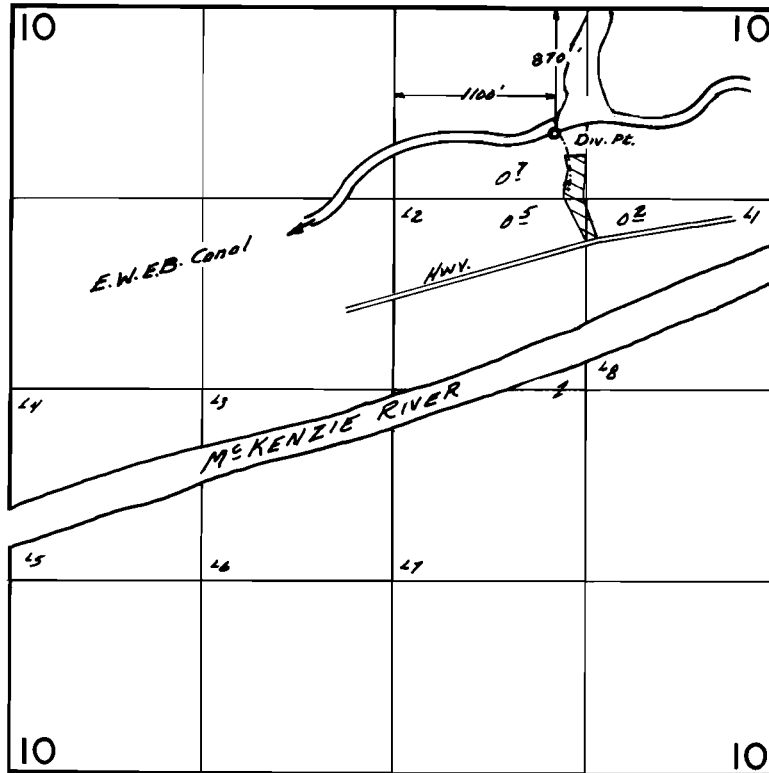

FINAL PROOF SURVEY UNDER

Application No. 50322. Permit No. 37.993....
IN NAME OF

.....GARLAND R. CABELL.....

Surveyed June 28, 1979., by S.C. BROWN.....