


T.19S. R.12 W. W. M.

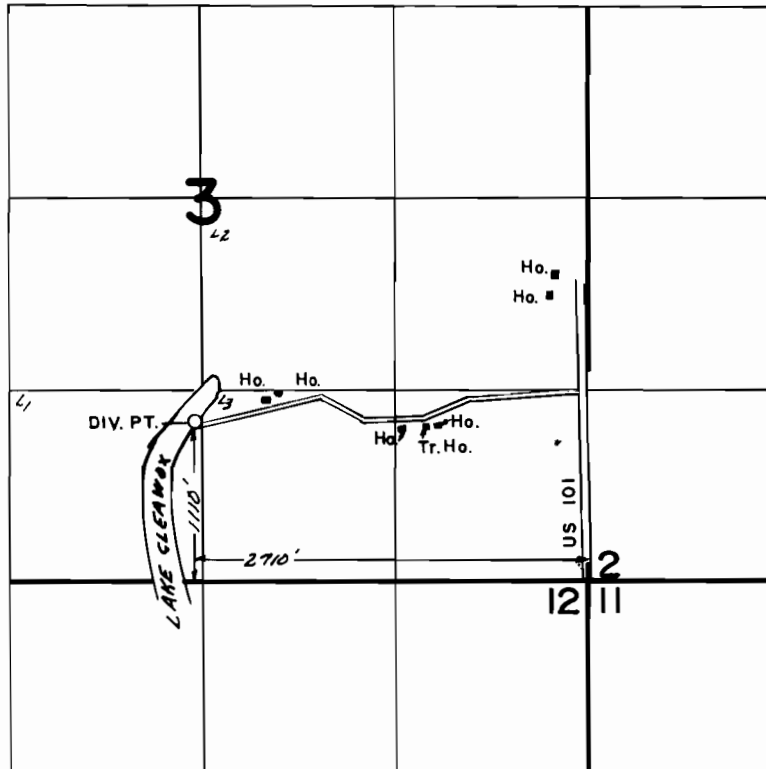

FINAL PROOF SURVEY UNDER

Application No. 508.7.3. Permit No. 38.4.10....
IN NAME OF

WESTERN AMERICAN DEVELOPMENT CO.

Surveyed Aug. 7, 1979, by S.C. BROWN.....