


T. 17S. R. 3W. W.M.

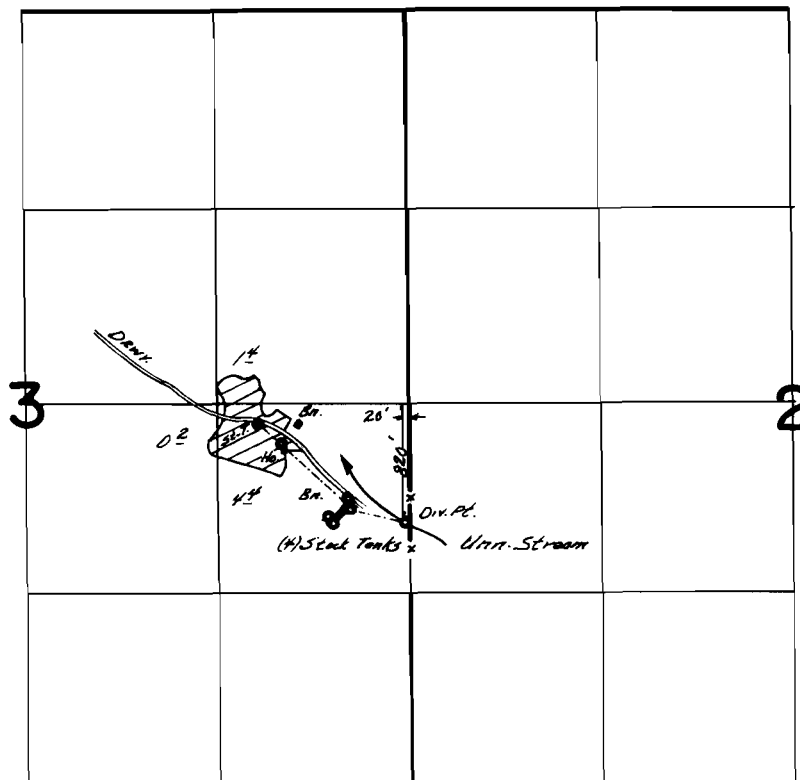

FINAL PROOF SURVEY
UNDER

Application No. 54649 Permit No. 41091.....
IN NAME OF

.....**ELSIE M. EGGE**.....

Surveyed May..16.. 1979., by **S.C. BROWN**.....