
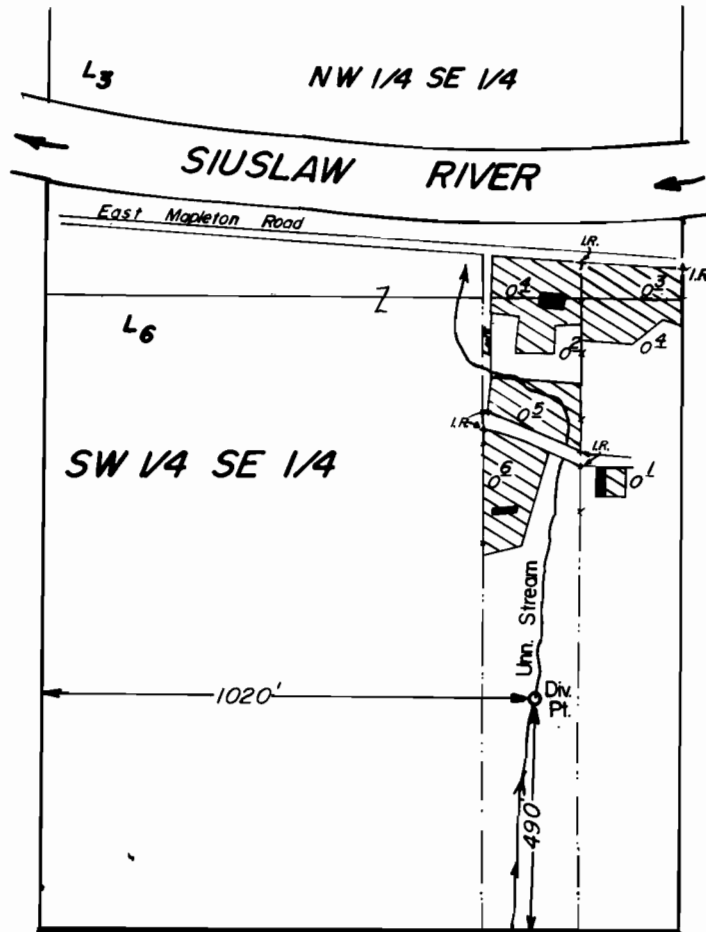


T. 17 S., R. 10 W., W. M.

SECTION 23

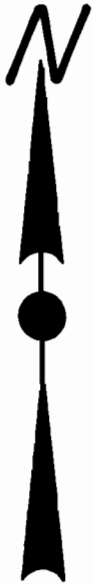

Scale: 1" = 400'

FINAL PROOF SURVEY

UNDER

T- 4554 B

Application No. 59738... Permit No. 45684.....

IN NAME OF

LAWRENCE N. & MARY L. KEZAR

Surveyed Sept. 24, 1985, by T. Warren.....