


T. 16 & 17 S. R. 3 W. W.M.

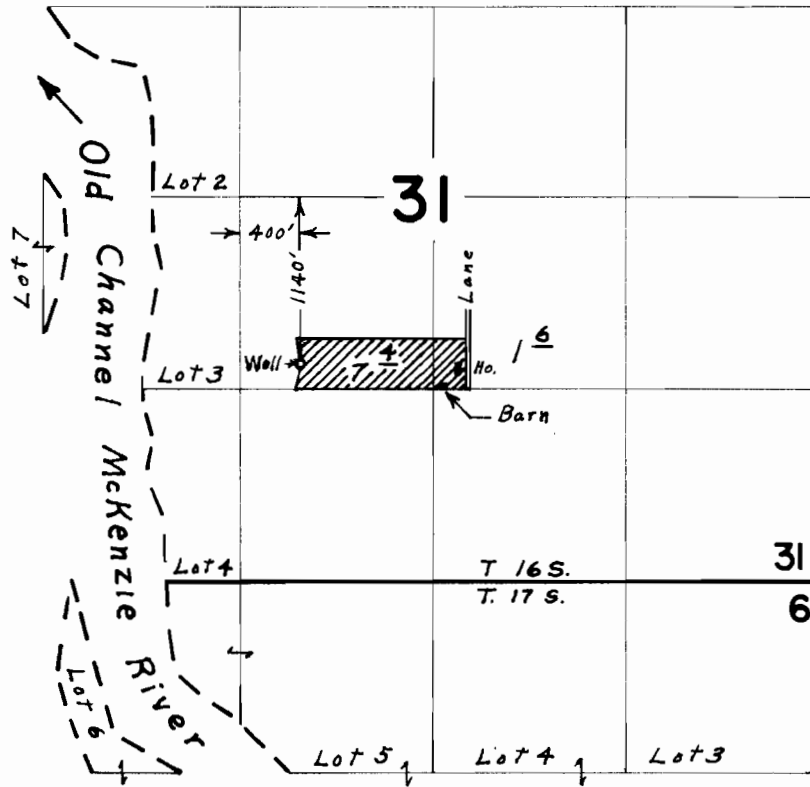

FINAL PROOF SURVEY

UNDER

Application No. G-4856 Permit No. G-4572

IN NAME OF

ESTATE OF CLEOFES C. WRIGHT

Surveyed June 18, 1970 by L. E. Gould