


T. 9 S., R. 2 E., W. M.

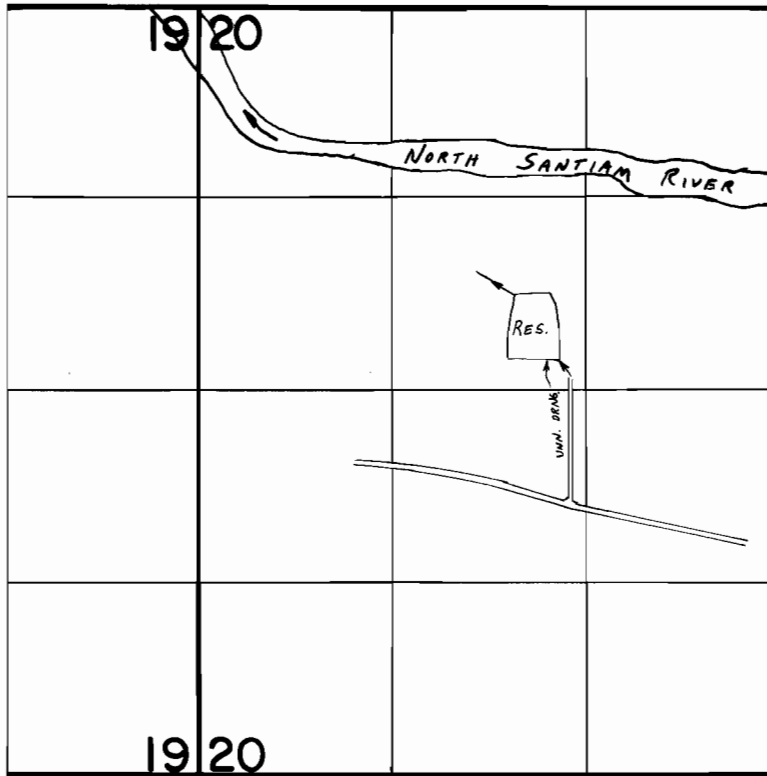

P.O.D. Loc. : 650' N. & 500' W. from C. 1/4 Cor. Sec. 20.

Scale: 1" = 1320'

**FINAL PROOF SURVEY**  
UNDER

R-62159

R-8475

Application No. 62160... Permit No. 46912.....

IN NAME OF

**HUGH M. & HELEN JOHNSTON**

Surveyed May...7.... 1986., by ..T.Warren.....

41043-178-40 D  
11/25/86 TMW