
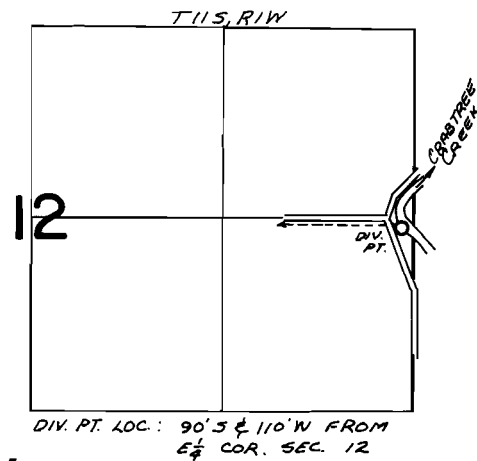


T.10&11S.,R.1W.,W.M

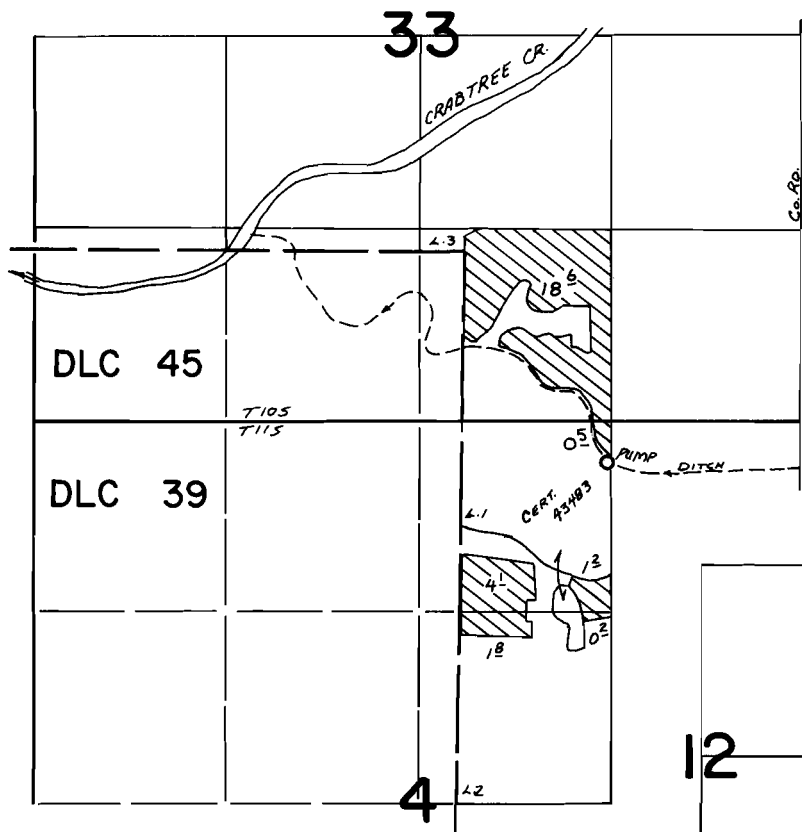

FINAL PROOF SURVEY UNDER

Application No. .55898. Permit No.41926.....
IN NAME OF

WESLEY D. JULSRUD

Surveyed June 29, 1982, by L. M. TOLL.....