
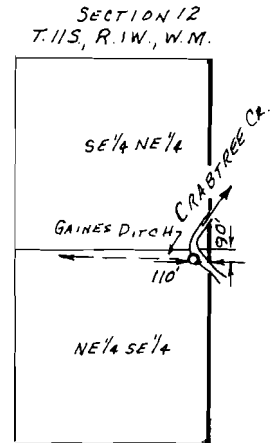


T.10&11S., R.1W., W.M.

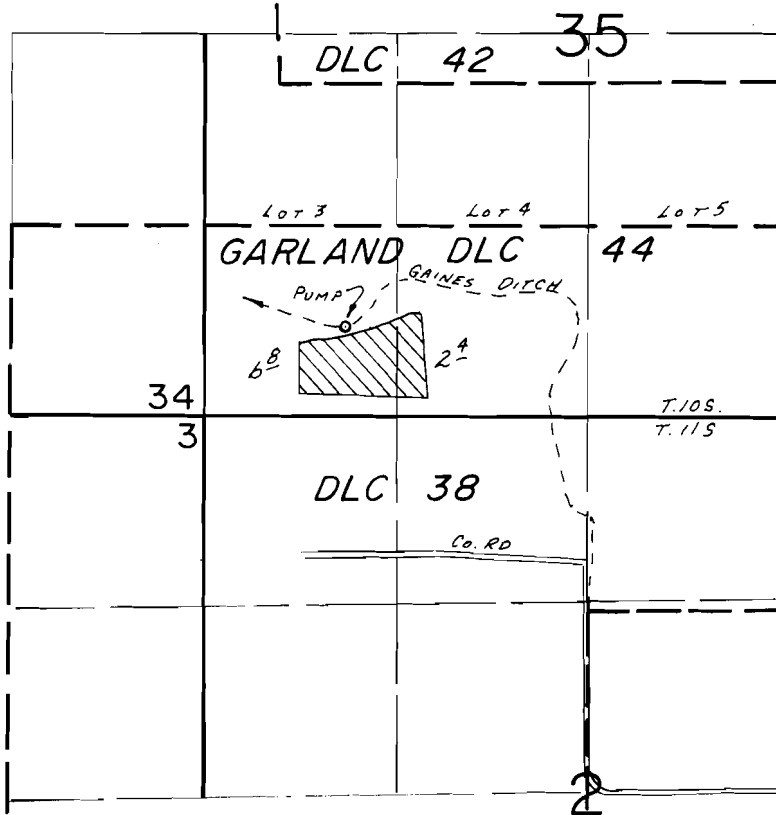

SCALE: 1" = 1320'

FINAL PROOF SURVEY UNDER

Application No. 57605.. Permit No. 43513.....
IN NAME OF

.....RIP J. & GUY P. LEWIS.....

Surveyed May 21... 19.86, by B.W. BISHOP.....

11/7/86
AWB