


T. 12 S., R. 2 W., W.M.

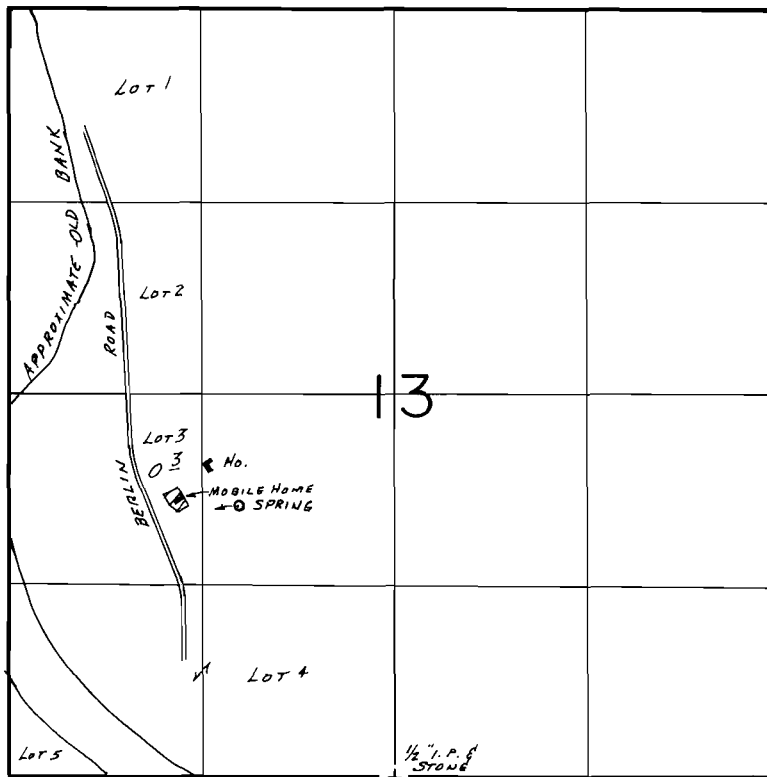

SPRING LOC.: 1860' N. & 1060' W. FROM S $\frac{1}{4}$ COR. SEC. 13.

SCALE: 1" = 1320'

FINAL PROOF SURVEY UNDER

Application No. 58716... Permit No. 45506.....
IN NAME OF

R. O. GARRISON

Surveyed June 6.... 1984, by B.W. BISHOP.....

11/17/86
BWB

41043-178-106 A