


T.15S.,R.47E.,W.M.

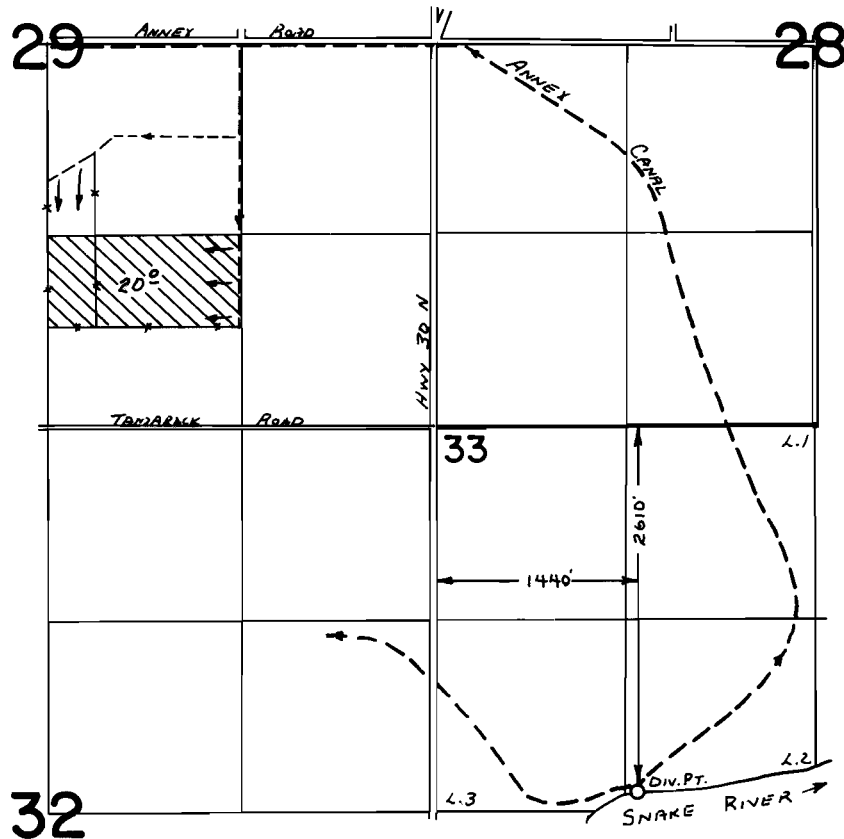

FINAL PROOF SURVEY
UNDER

Application No. 54165... Permit No. 40549....
IN NAME OF

FRANK OR CAROL BRISTOW

Surveyed Aug. 17... 1983, by L. M. TOLL.....