


T.18S.,R.46E.,W.M.

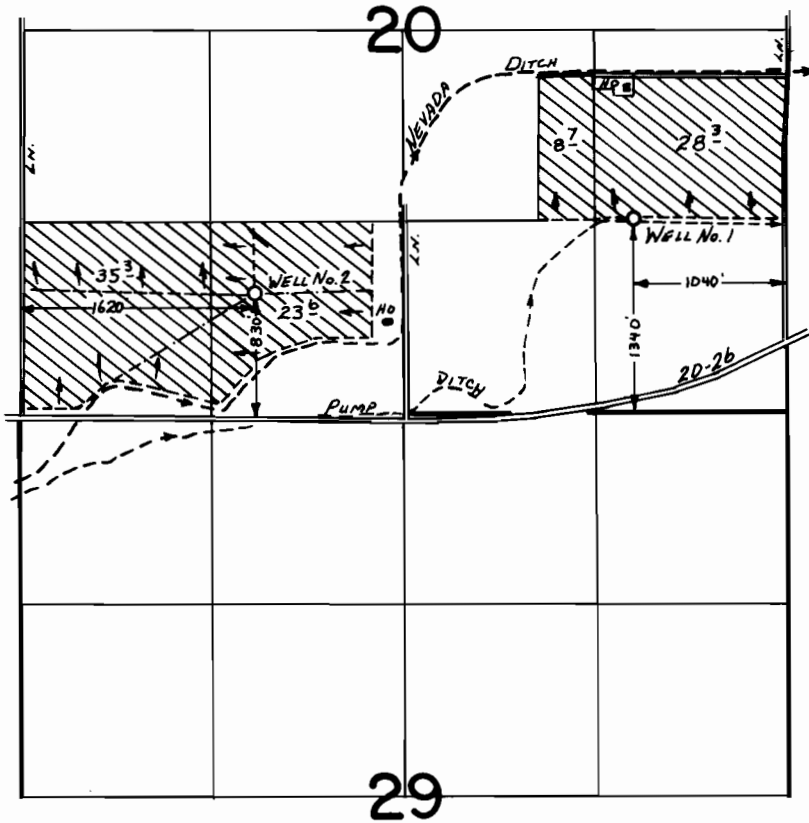

FINAL PROOF SURVEY
UNDER

Application No. ..G:8208. Permit No. ..G:7833.....
IN NAME OF

.....LEE..... FARMS,..... INC.....

Surveyed .Aug..24... 19.83., by ...L..M..IOLL.....