


T. 7S., R. 1E., W.M.

Sec. 1

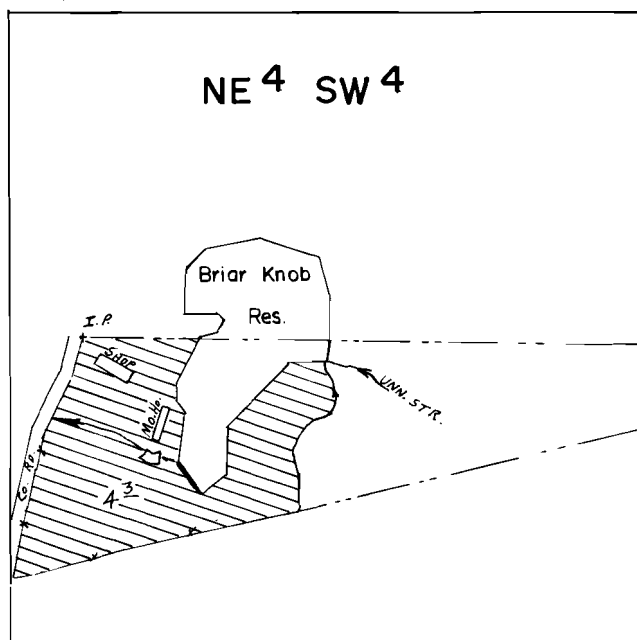

Dam Loc.: 960' S. & 940' W. from C. 1/4 Sec. 1.

Scale: 1" = 400'

FINAL PROOF SURVEY UNDER

R-61576 R-8280
Application No. 60277... Permit No. 45855...
IN NAME OF

HANK KEETON

Surveyed April 23, 1986., by J. Warren.....