


T. 4S., R. 2W., W.M.

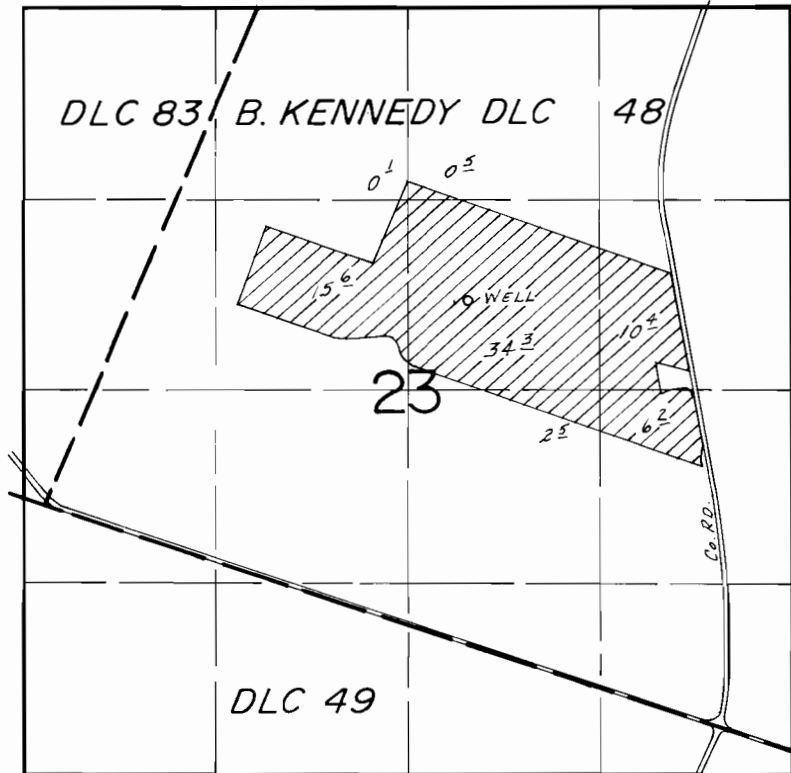

WELL Loc.: 1420 N. & 2900 E. FROM SW COR. B. KENNEDY DLC 48.

SCALE: 1" = 1320'

FINAL PROOF SURVEY
UNDER

Application No. G:11245. Permit No. G:10359...

IN NAME OF

..... JAMES DAUGHERTY

Surveyed Mar. 30, 1986, by J.M. WARREN....