
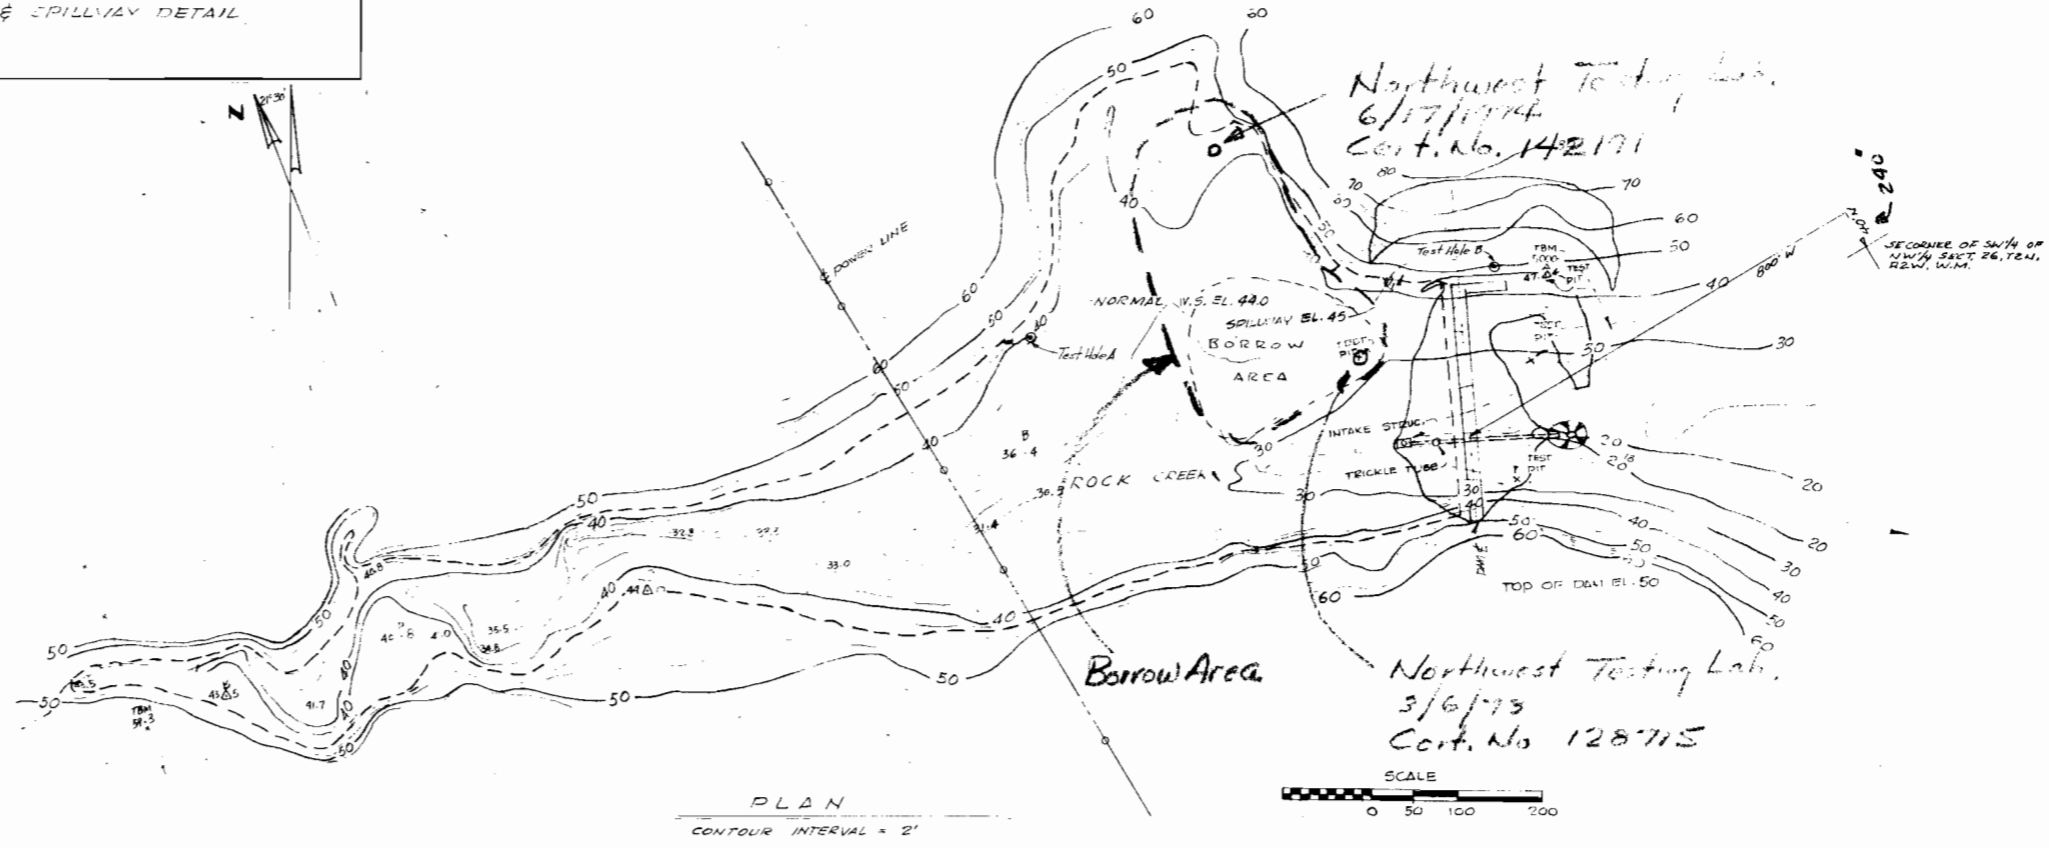


THIS IS A REDUCTION

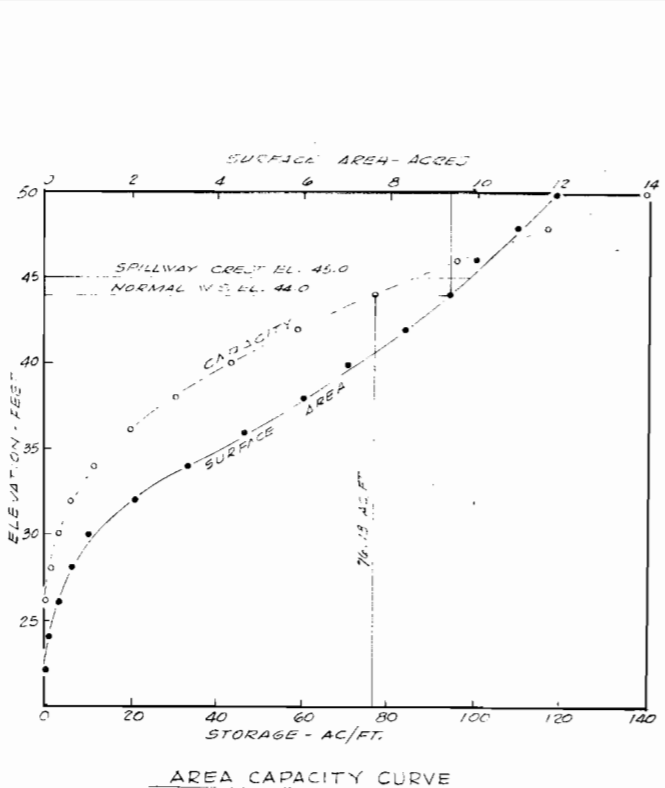

DESIGNED	A. KLEIN	APPROVED	
DRAWN	D. McLEARN	SCALE SHOWN	DATE 12-1-73
CHECKED		FILE	
DATE	NO.	REVISION	BY
1-14-74	A	FURNISH REVISION	D.M.

**KLEIN CONSULTING ENGINEERS**  
CIVIL ENGINEERS - PLANNERS  
FOREST GROVE, OREGON

VAN RADEN DAM

PLAN AND LOCATION MAP

SHEET 1A  
4