


T. 2N., R. 32 & 33E., W.M.

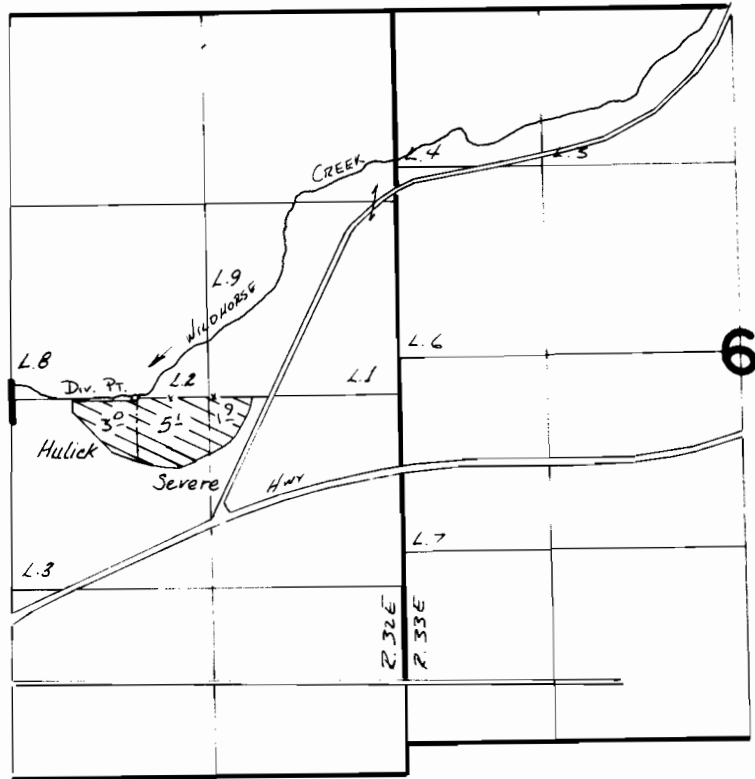

DIV. PT. LOCATED 10' N. & 1820' W. FROM E 1/4 COR. SEC 1

SCALE: 1" = 1320'

FINAL PROOF SURVEY UNDER

Application No. **8740**..... Permit No. **5705**.....
IN NAME OF

DELORES SEVERE & DON HULICK

Surveyed Jan. 21..... 1986., by V. G. Church.....