


T.2&3N. R. 30E., W. M.

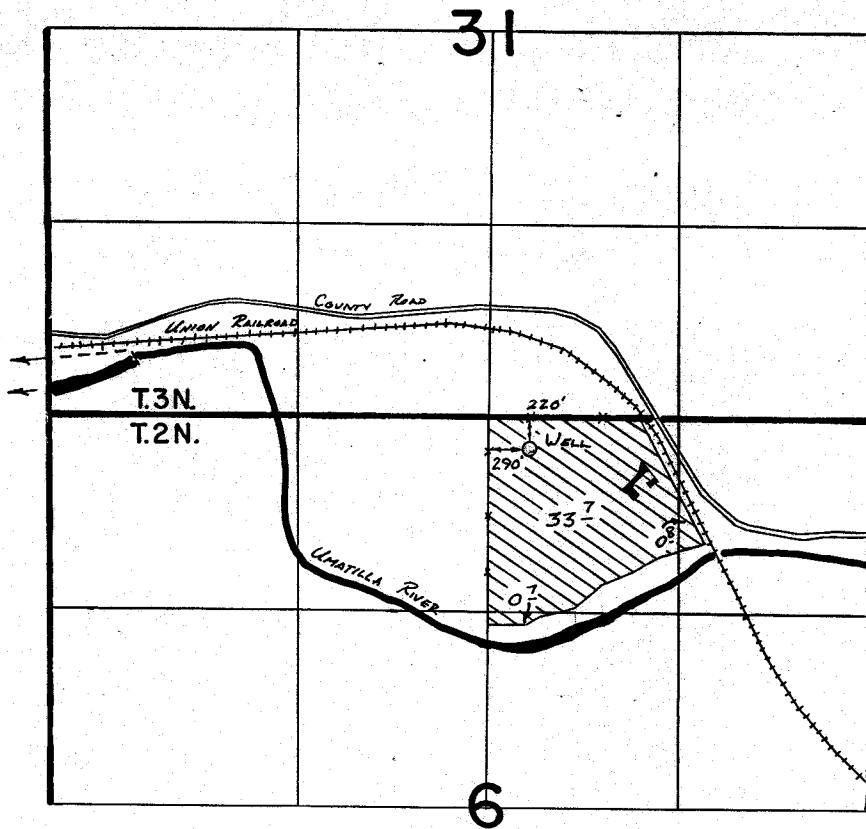

FINAL PROOF SURVEY UNDER

Application No. G:6790 Permit No. G:6672...
IN NAME OF

.....CLAYTON E. B. CAROL L. HORN.....

Surveyed May 31, 1983, by J. L. Church.....