


T. 4N., R. 34E., W. M.

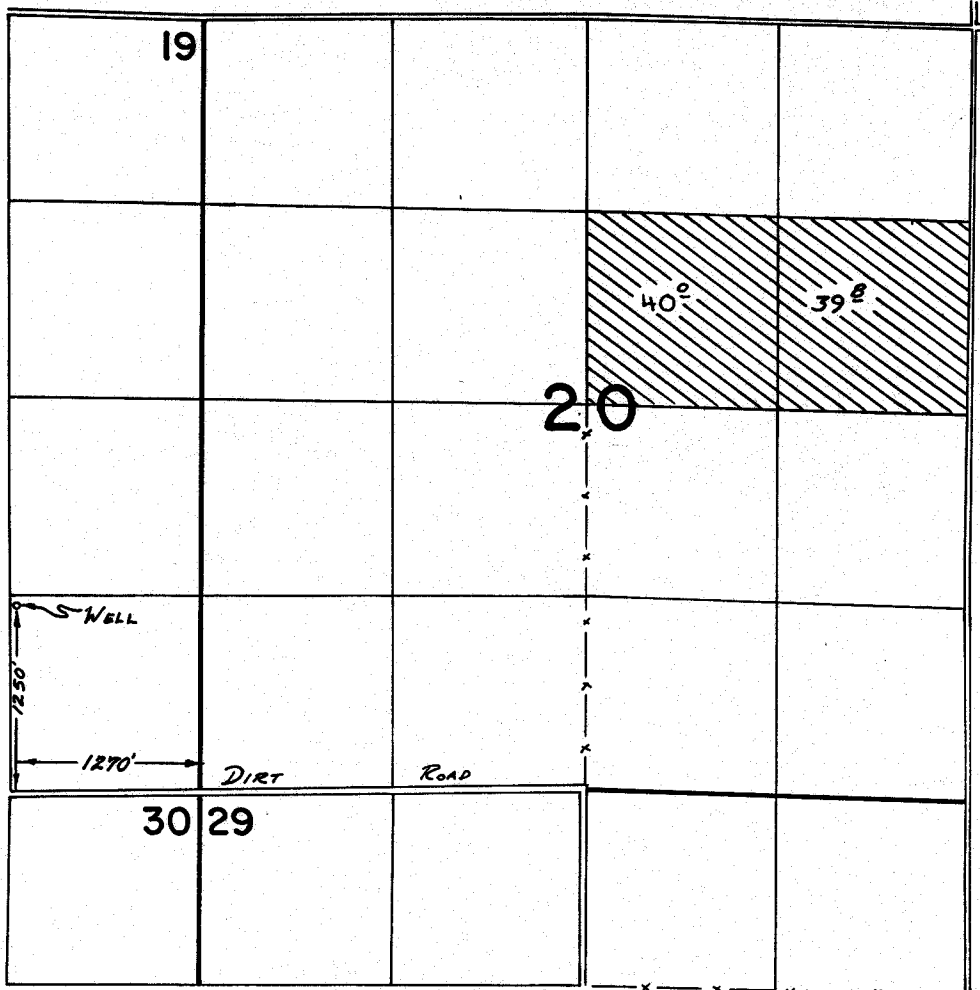

SCALE: 1" = 1320'

FINAL PROOF SURVEY
UNDER

Application No. G:9716.. Permit No. G:8967..
IN NAME OF

.....JOHNS RANCH.....

Surveyed 19:16..... 1984., by V. L. Church.....