


T. 4S., R. 39E., W. M.

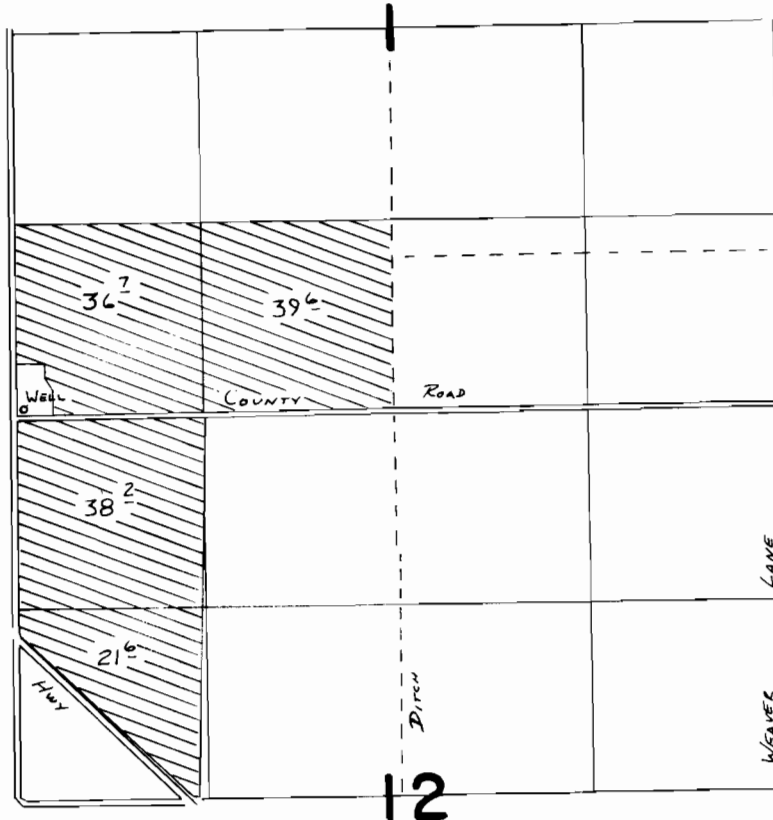

SCALE: 1" = 1320'

WELL LOCATED 60' N. & 70' E. FROM SW COR. SECTION 1

FINAL PROOF SURVEY UNDER

Application No. **G:10568** Permit No. **G:9850...**
IN NAME OF

.....**EDWARD E. & VIVIEN V. WAITE**.....

Surveyed 7-9..... 1984, by **A. L. Church**.....