


T. 2S., R. 1W., W. M.

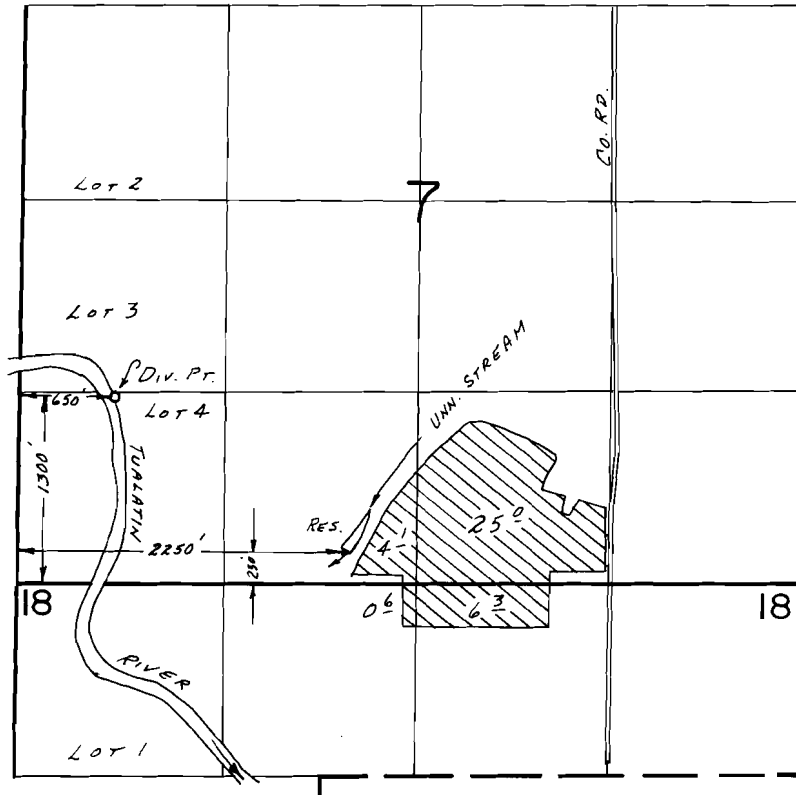

SCALE: 1" = 1320'

FINAL PROOF SURVEY
UNDER

R-54627 R-6528
Application No. ~~54628~~ Permit No. ~~40915~~.....
IN NAME OF

.....BAGGENSTOS FARMS.....

Surveyed Aug. 2..... 1985, by J.M. WARREN...
July 2 1986 B.W. BISHOP

11/29/86
BWB