


T. 2S., R. 1W., W.M.

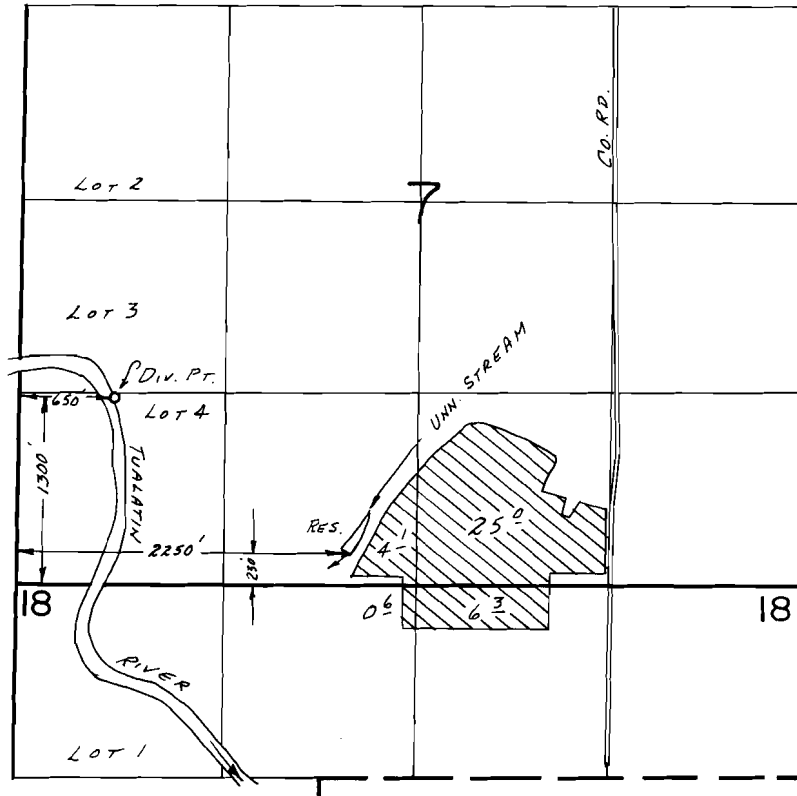

SCALE: 1" = 1320'

FINAL PROOF SURVEY UNDER

R-54627 R-6528
 Application No. ~~54628~~ Permit No. ~~40915~~.....
 IN NAME OF

.....BAGGENSTOS FARMS.....

Surveyed Aug. 2, 1985, by J.M. WARREN...
 July 2, 1986 B.W. BISHOP

11/29/86 *BWB*

41067-278-224 D