


T.I.S., R.I.W., W.M.

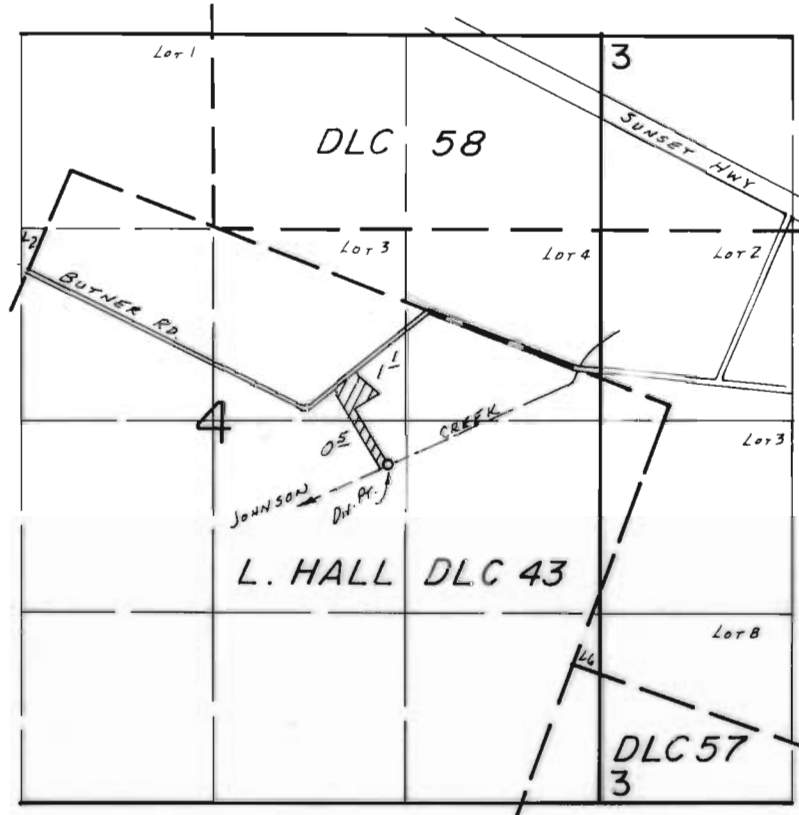

Div. Pt. Loc.: 2950 S. & 1450 W. FROM NE COR. SEC. 4.

SCALE: 1" = 1320'

FINAL PROOF SURVEY UNDER

Application No. 52716... Permit No. 39701.....
IN NAME OF

.....JAMES D. & PATRICIA C. SMITH

Surveyed July 3..... 1986, by B.W. BISHOP.....

11/24/86
BWB