

16

Note: Streams, except,
irrigated land, sketched
location.

21

17

20

18

19

04

Thomas Mabe

Lot 2

34

Lot 3

Surveyed Nov. 6, 1925.


TOWNST

Surveyed Oct. 30 to 11

*Federal Land Bank
(J.I. Thomas)*

On

2

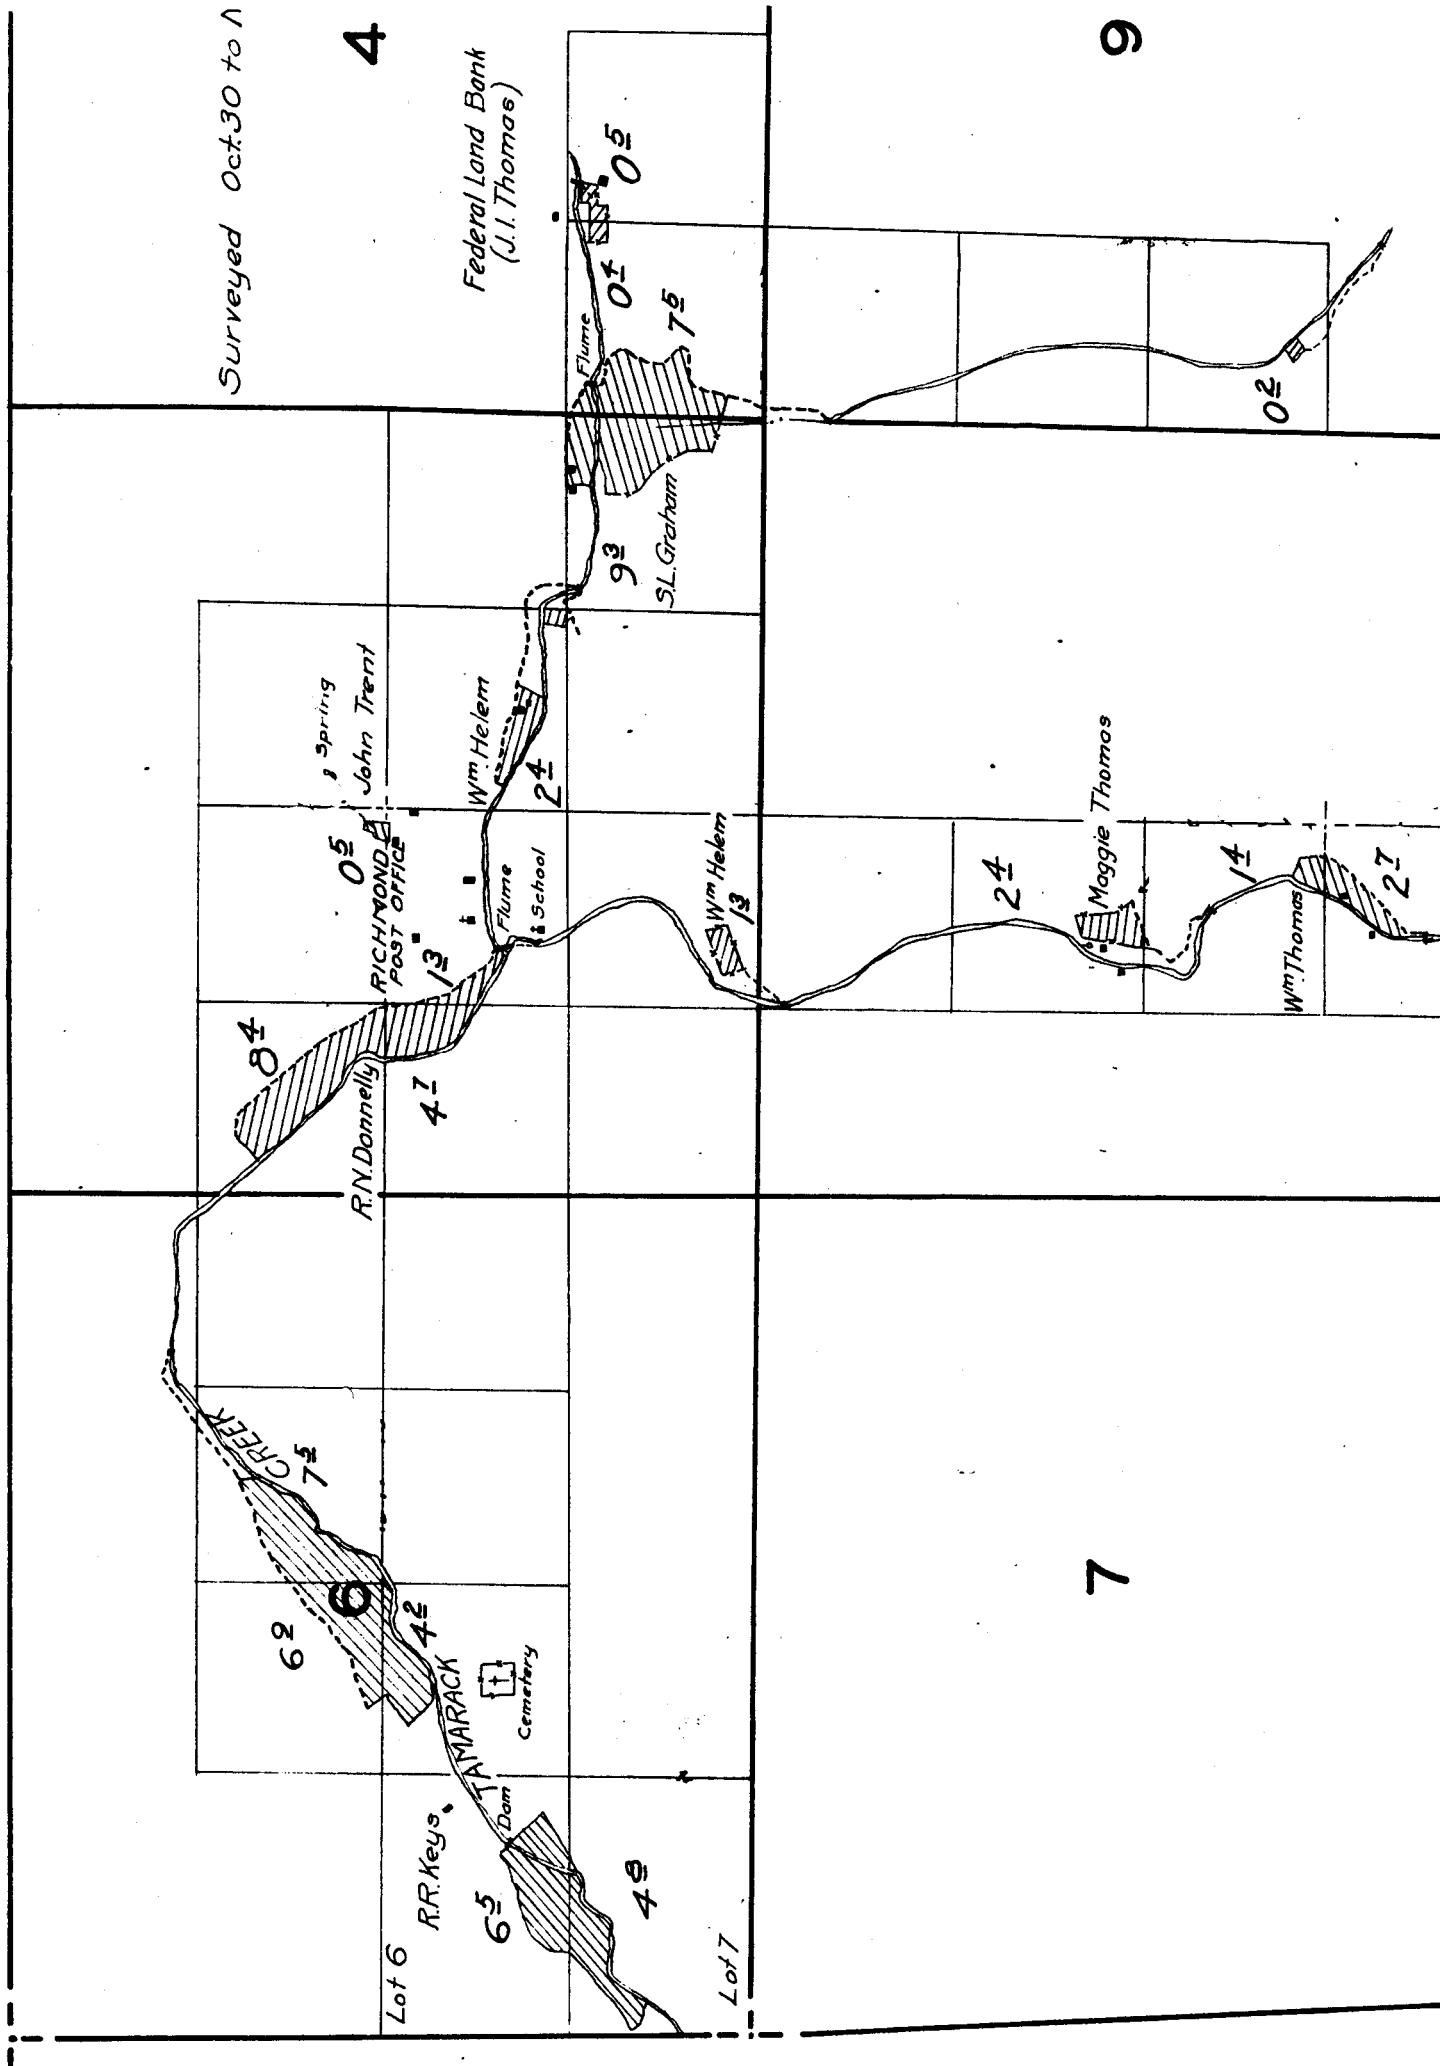


TOWNSHIP 10 S., RANGE 23 E.

Surveyed Oct. 30 to Nov. 3, 1925.

4

Federal Land Bank
(J.I. Thomas)

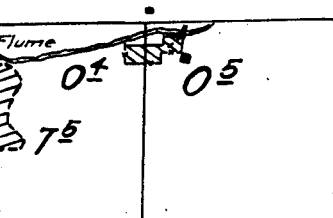

3

Note: Location of ditch & creek
sketched in field.

Lot 1

Lot 4

74

64

Thick

Pin

9

10

23

24

26


25

35

36

19


20

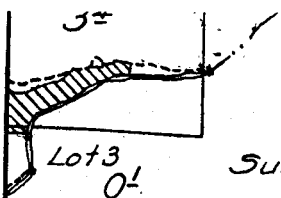

Surveyed Nov. 6, 1925.

30

29

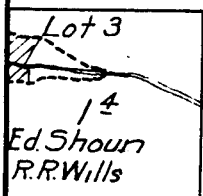

31

32

15


14

13

22

23

24

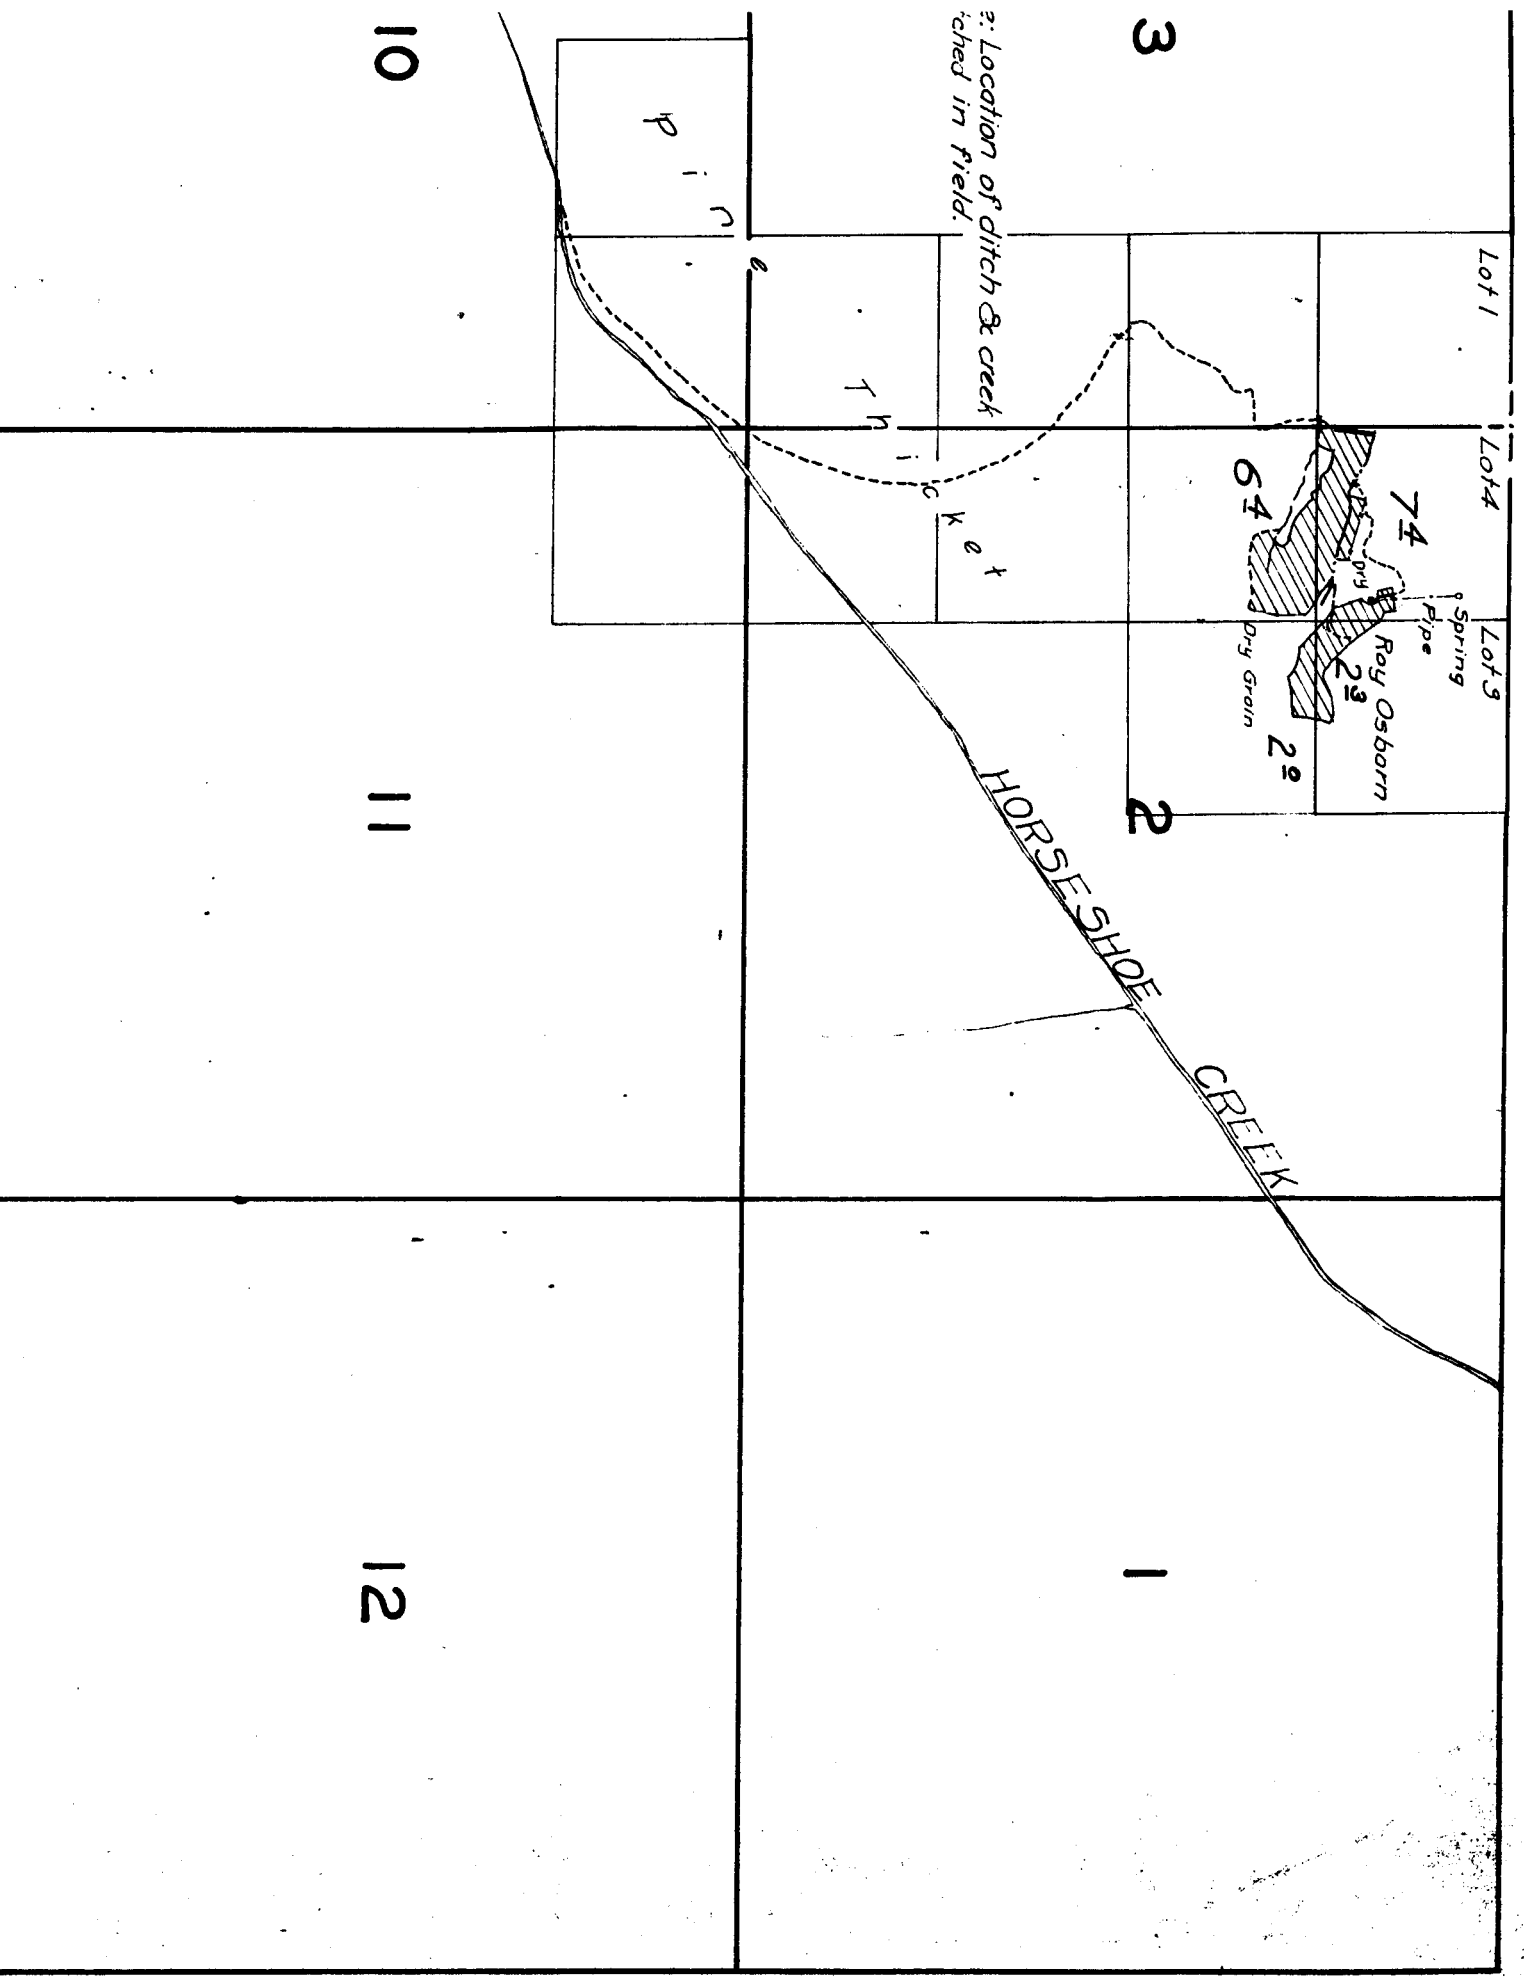

29

28

27

32

33

34

17

16

15

*Note: Streams, except in the vicinity of
irrigated land, sketched in approximate
location.*

20

21

22