


T10S. R7W. WM.

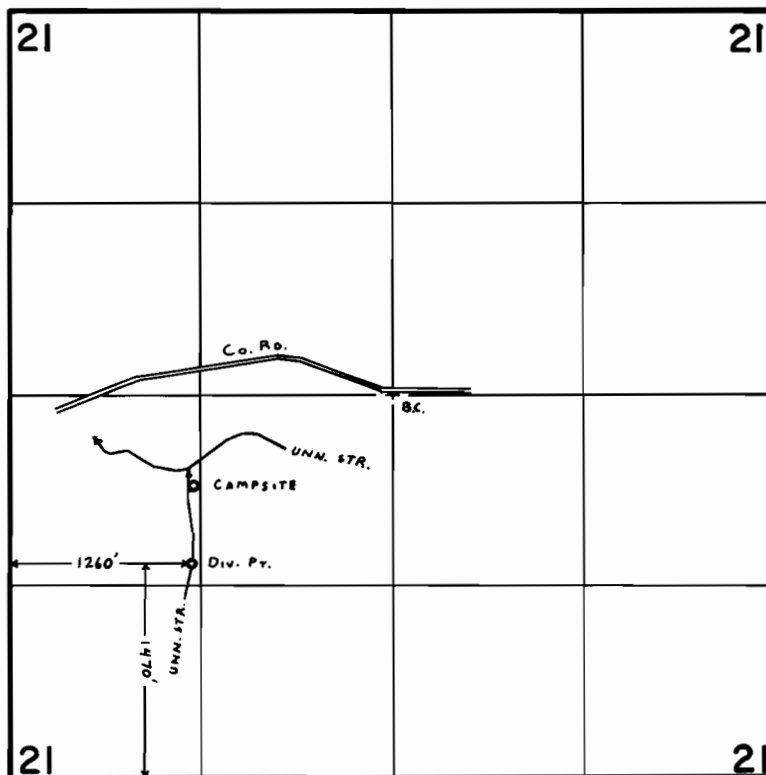

FINAL PROOF SURVEY UNDER

Application No. 49021 Permit No. 36692

IN NAME OF

HARALD L. & LINDA ENZ, JR.

RAMON W. & CLAUDIA HOUSE

Surveyed May 3, 1979, by C. L. HUGHES