


T.5S.,R.1&2E.

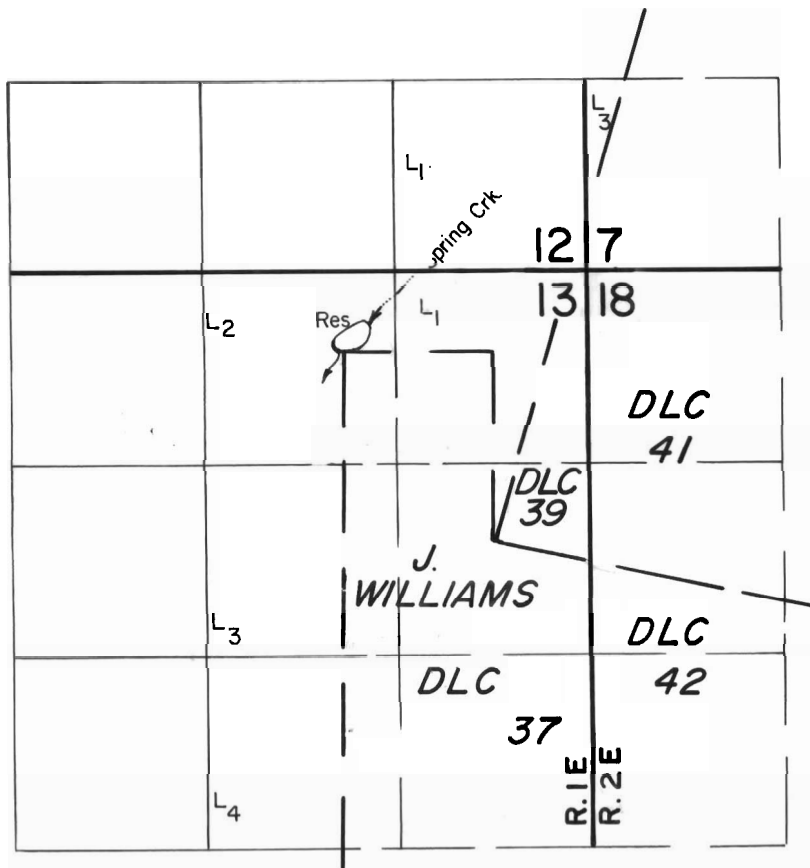

Scale: 1" = 1320'

**FINAL PROOF SURVEY**  
UNDER

Application No. R-54854 Permit No. R-6557....  
IN NAME OF

.....**RONALD HEYERLY**.....

Surveyed **JULY 12, 1985**, by **T. Warren**.....