T. 3S., R. 2E., W.M.

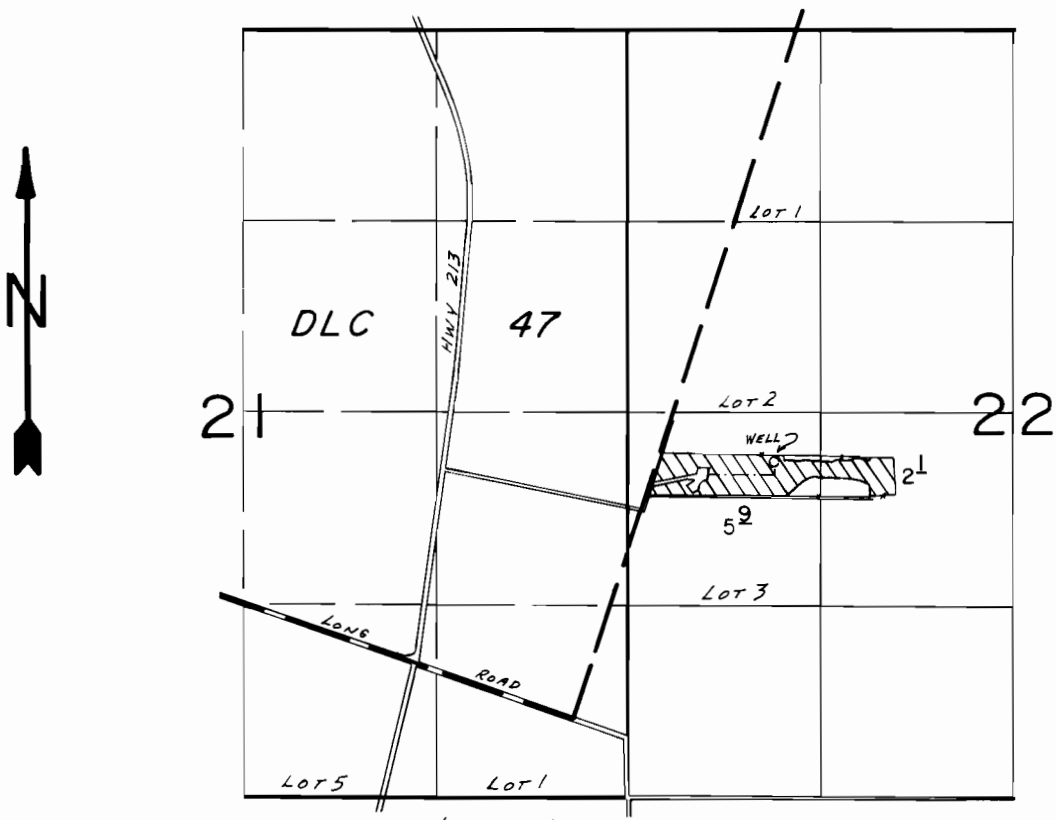

WELL LOC: 2300'N. & 1000'E. FROM SW COR. SEC. 22.

SCALE: 1"=1320'

FINAL PROOF SURVEY

UNDER

Application No. G-8518 Permit No. G-7864

IN NAME OF

HAROLD N. BIGHAM

Surveyed AUG. 9 1984, by B.W. BISHOP

SEPT. 3 1986, by T. WARREN

Revised: 2-11-87

41005 278 177A