


T. 28 S., R. 12 W., W. M.

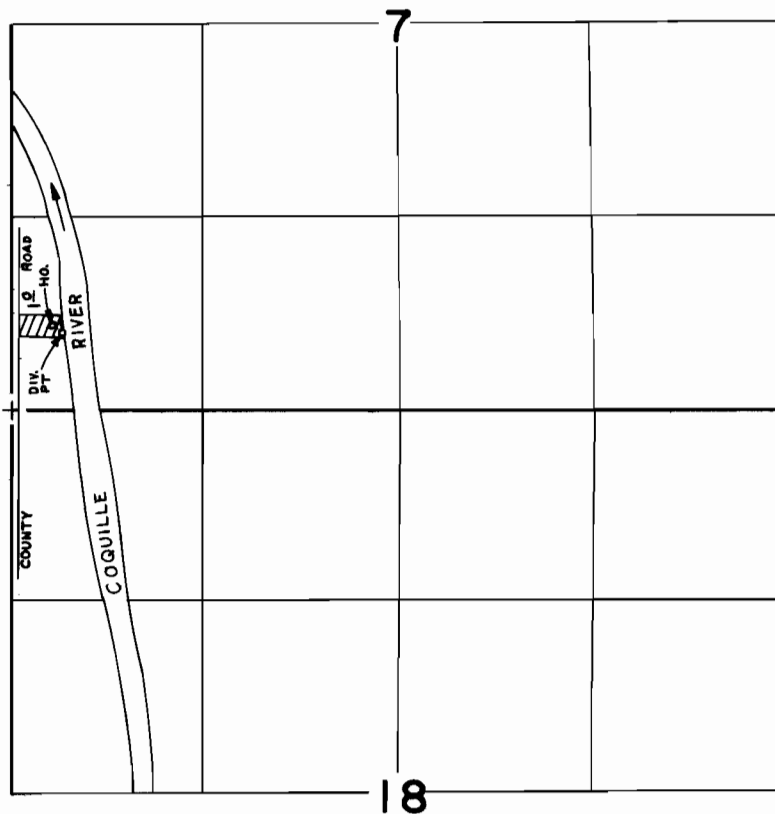

DIV. PT. LOCATED 535' N. & 345' E. FROM S.W. CORNER SECTION 7

SCALE: 4" = 1 mile

FINAL PROOF SURVEY UNDER

Application No. 58968... Permit No. 44452...
IN NAME OF

JAMES S. FRAKES

Surveyed OCT. 12, 1983, by L. CASHION...