


T. 28 S., R. 12 W., W. M.

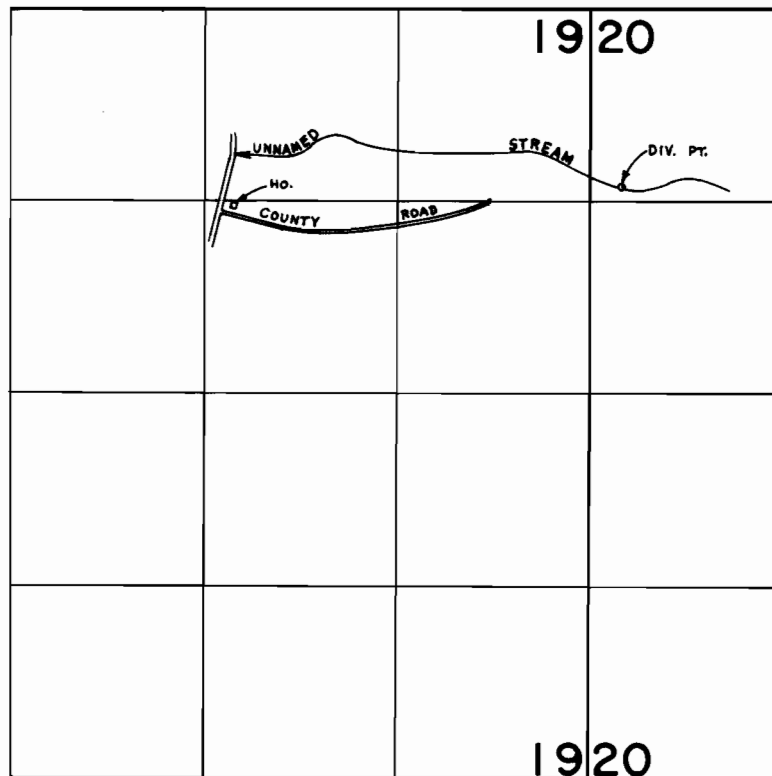

DIV. PT. LOCATED 1,215' S. & 210' E. FROM N.W. CORNER SECTION 20

SCALE: 4" = 1 mile

FINAL PROOF SURVEY
UNDER

Application No. 59344 Permit No. 44849
IN NAME OF

FLORIAN GANTENBEIN

Surveyed OCT. 13, 1983, by L. CASHION