


T.41S., R.13W., W.M.

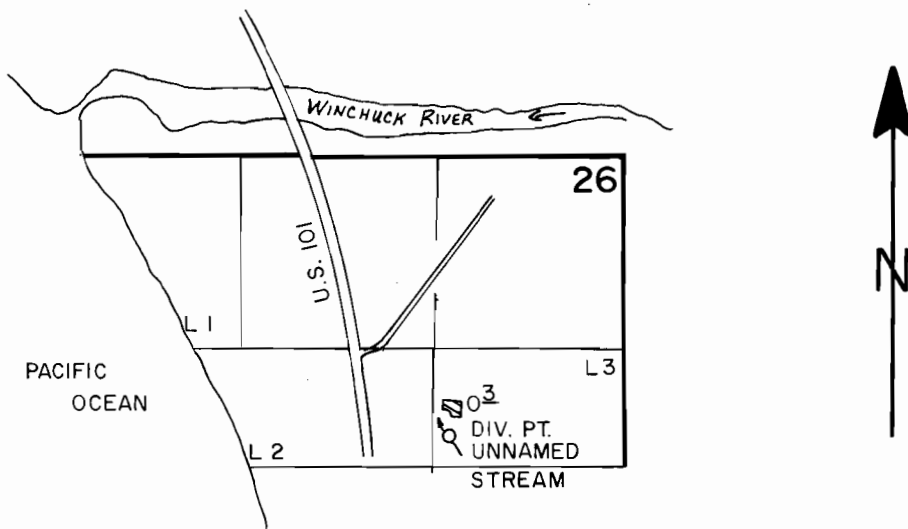

DIV. PT. LOC. 1920' S. & 1100' W. FROM THE N.E. COR. SEC. 26.

SCALE 1" = 1320'

FINAL PROOF SURVEY
UNDER

Application No. 60139 Permit No. 45068
IN NAME OF

JOHN AND/OR DEHRA MAYBO

Surveyed APRIL 8 1985, by L. E. CASHION