


T. 29 S., R. 4 W., W.M.

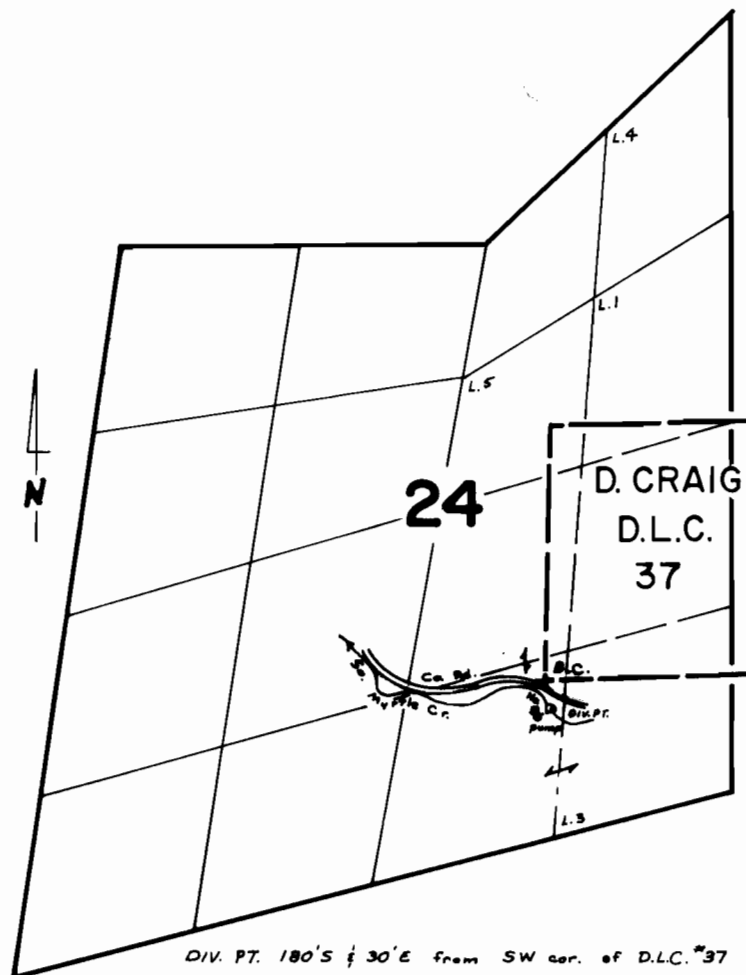

Scale 4" = 1 mile

FINAL PROOF SURVEY UNDER

Application No. 50582. Permit No. 381.86.....
IN NAME OF

GARY E. & TONI F. LEWIS.....

Surveyed Nov..8.,... 1979, by S. Donaldson.....