


T. 29 S., R. 5 W., W. M.

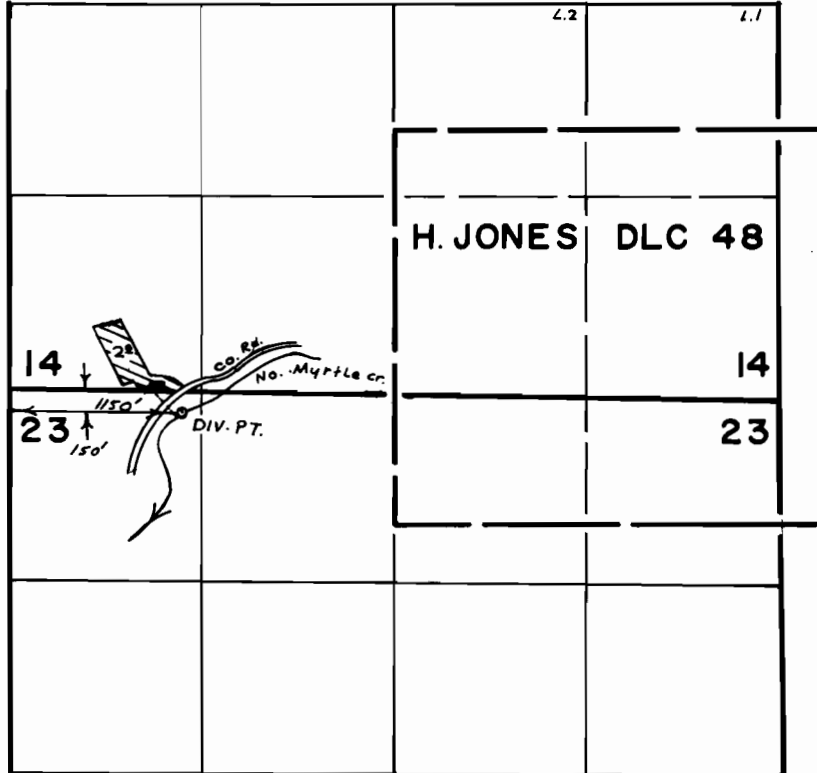

SCALE 4" = 1 mile

FINAL PROOF SURVEY UNDER

Application No. 54803. Permit No. 41114.....
IN NAME OF

.....EDGAR.....B.....KING.....

Surveyed Dec. 11. 1979, by S. Donaldson