


T-5165

T. 15 S., R. 31 & 32 E., W.M.

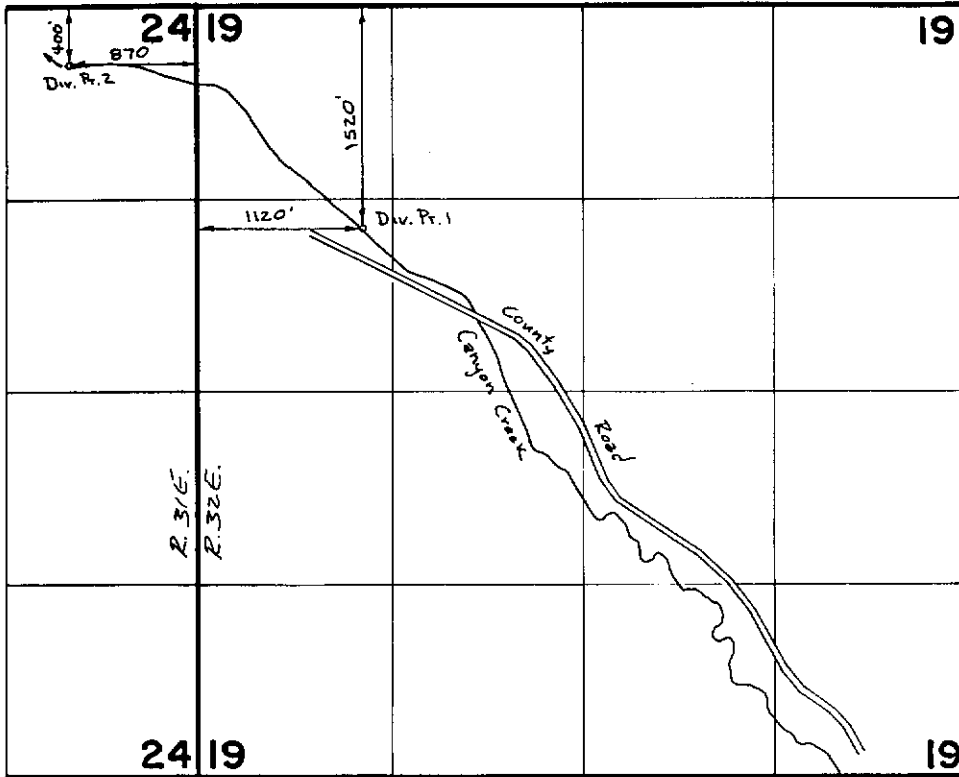

SCALE 1" = 1320'

FINAL PROOF SURVEY
UNDER

TRANSFER 5165

IN NAME OF

A - BAR - L RANCH

Surveyed 4-9 1986, by L. Tol