


P# 38355

T. 1N., R. 10E., W. 1M.

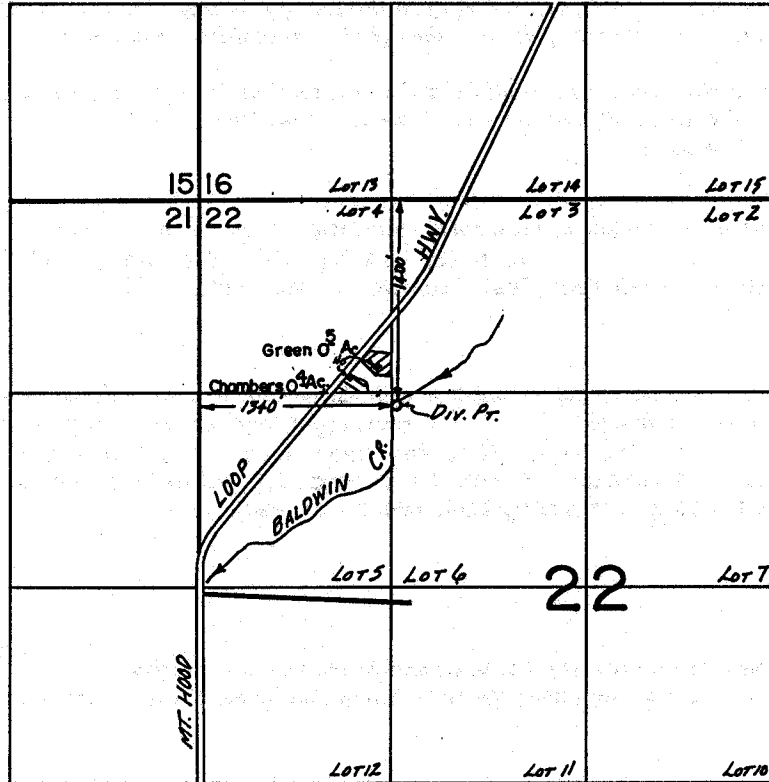

FINAL PROOF SURVEY
UNDER

Application No. 50795... Permit No. 38355.....
IN NAME OF

.....DANNY R. GREEN & TIM CHAMBERS.....

Surveyed APR. 18... 1980, by R.G. MUCKEN.....

PHOTO: 27-85 SE
BAB