


T. 35 S., R. 4 W., W. M

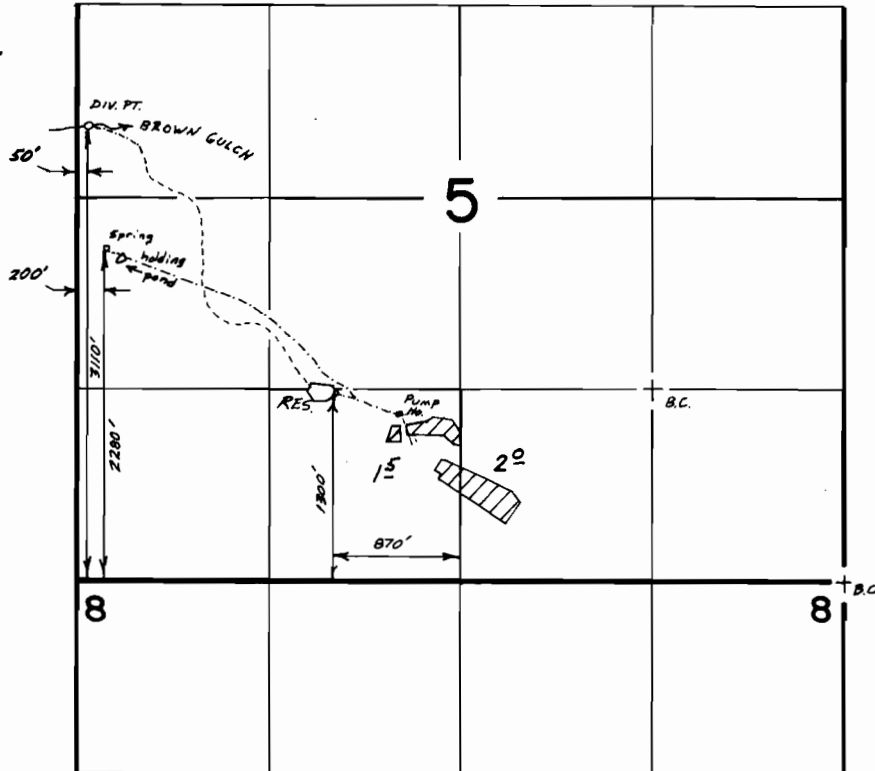

Scale 1"=1320'

FINAL PROOF SURVEY UNDER

R-48946 R-5937

Application No. 48947. Permit No. 36650.....

IN NAME OF

..... ROBERT L. STEVENSON

Surveyed Aug. 14, 1985, by BS. JAMES.....