


T.35S., R.2W., W.M.
SEC. 32

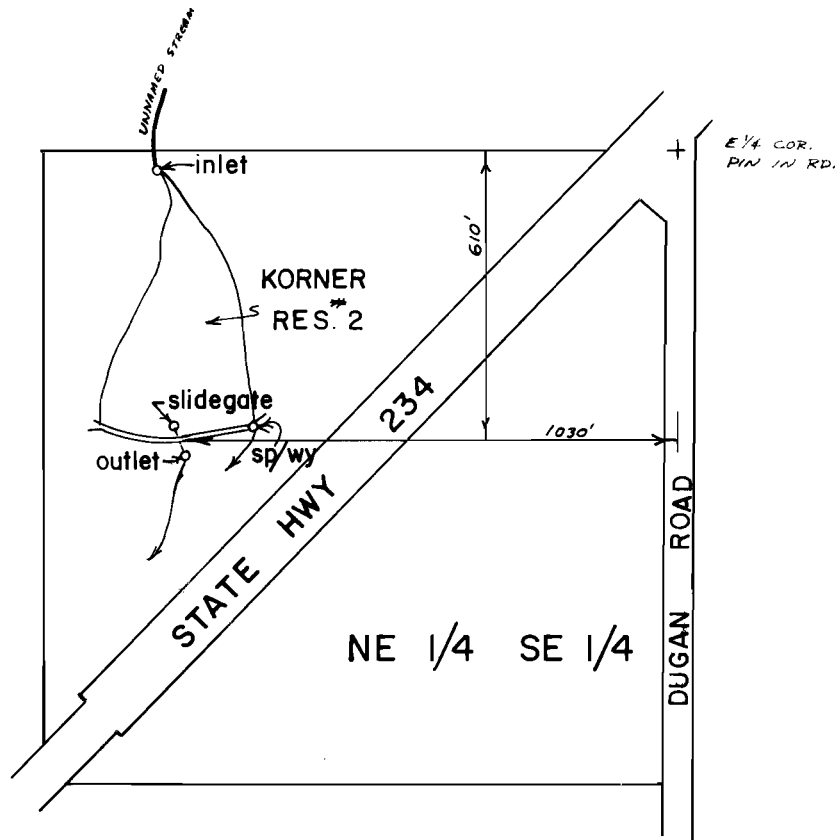

Scale : 1" = 400'

FINAL PROOF SURVEY
UNDER

R-54120

R-6456

Application No. 54121.... Permit No. 40515.....

IN NAME OF

P. A. 8 / or CHARLOTTE HINES.....

Surveyed SEPT. 18, 1981., by Bruce R. Sund