


T. 35 S., R. 3 W., W.M.

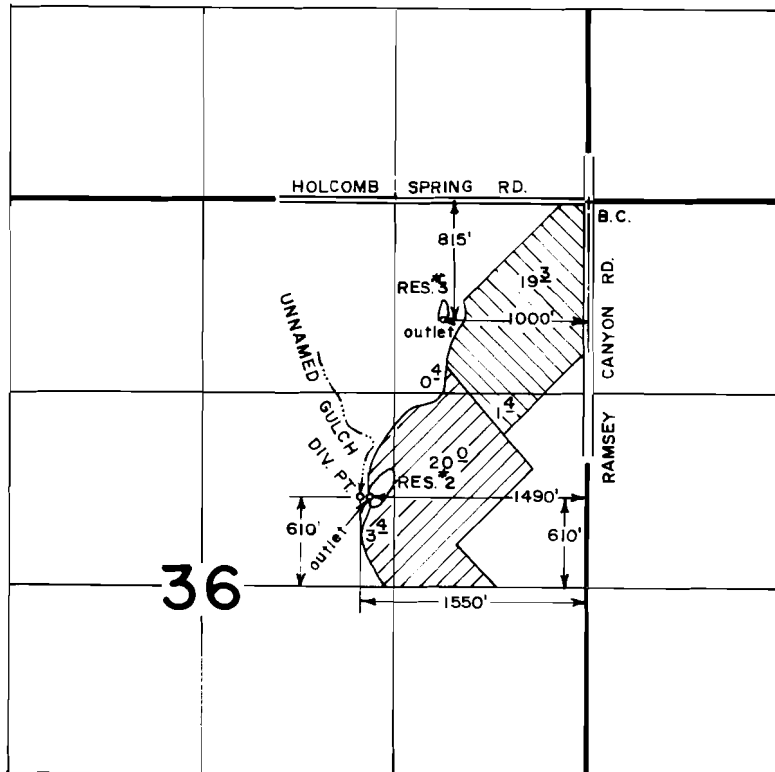

FINAL PROOF SURVEY
UNDER

R-58670 R-8107
Application No. 58671 Permit No. 44781
IN NAME OF

ASSOCIATED FRUIT COMPANY

Surveyed OCT. 19 1982, by B. S. JAMES

SCALE: 4" = 1 MILE

 RES. #2
 RES. #3