


T. 37S., R. 4 W., W.M.

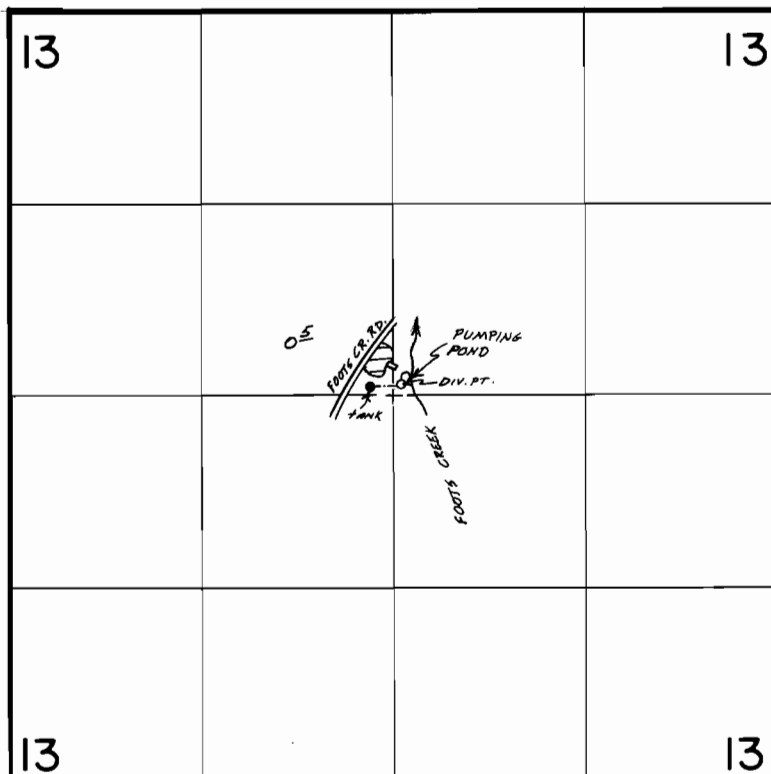

DIV. PT. : 60' N & 50' E FROM C 1/4 COR.

Scale 1" = 1320'

FINAL PROOF SURVEY UNDER

Application No. 49870. Permit No. 36734.....
IN NAME OF

GERALD & SHARON LEE EASLEY

Surveyed Oct. 9, 1985, by B.S. JAMES.....