




T. 38 S., R. 4 W., W.M.

Sec. 25

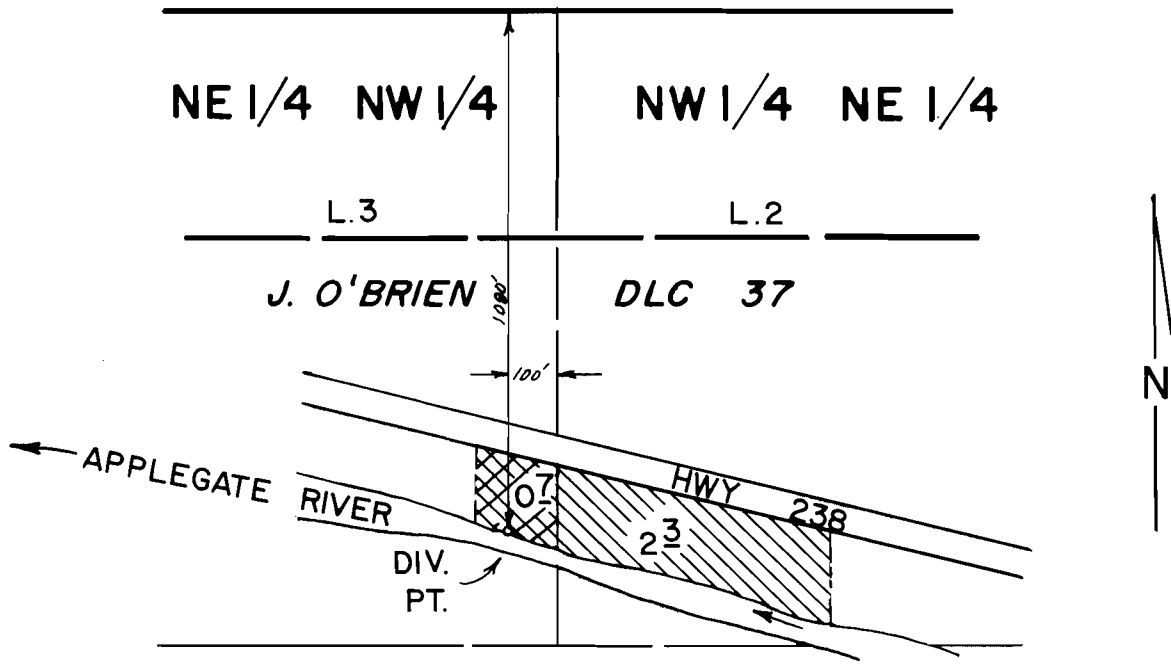

Scale 1"=400'

PRIMARY -  SUPPLEMENTAL - 

**FINAL PROOF SURVEY**  
UNDER

Application No. 62320 Permit No. 46087  
IN NAME OF

RICHARD L. &/or ANN OFFENBACHER

Surveyed August 22, 1985, by B.S. JAMES