


T. 39S., R. 4W., W.M.

SEC. 7

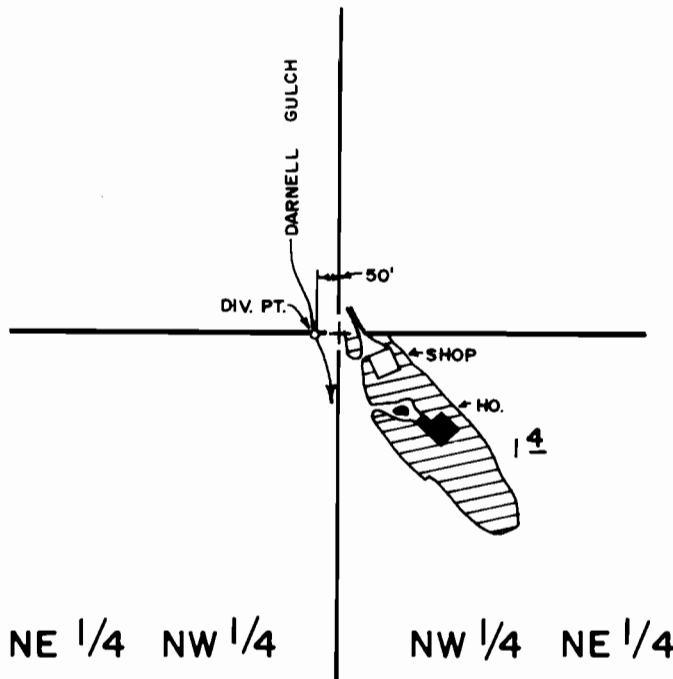

FINAL PROOF SURVEY
UNDER

Application No. 54689.. Permit No. 41Q32.....
IN NAME OF

.....NORMAN.....D.....BEHM.....

Surveyed MAY 13, 1982, by B.R. SUND.....

SCALE : 1" = 400'