



# T.38S., R.4W., W.M.

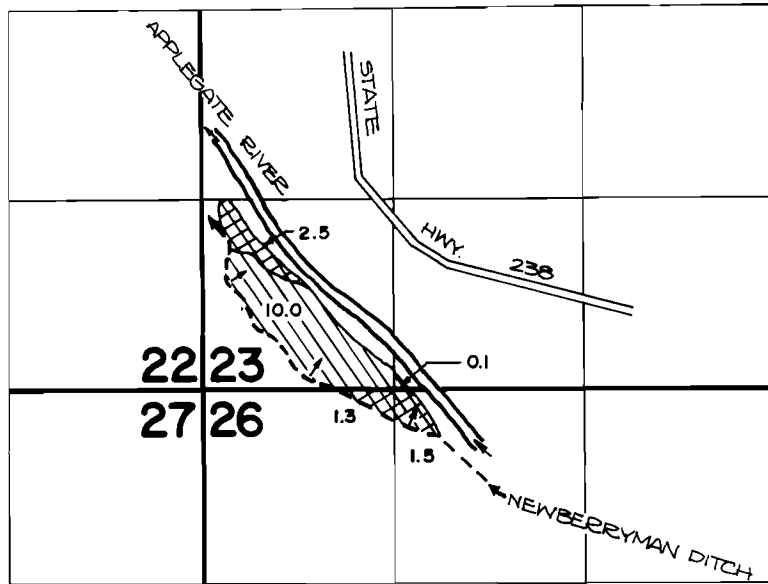

PERMIT 45962



PERMIT 41702

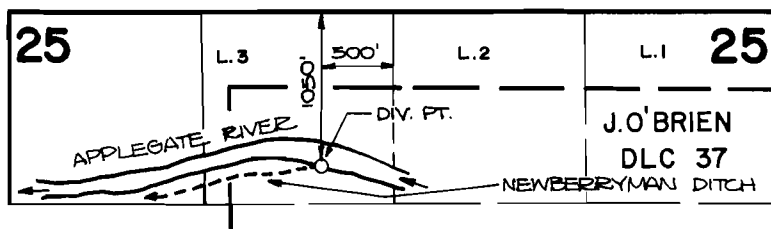

## FINAL PROOF SURVEY UNDER

62133                      45962  
 Application No. ~~55669~~ Permit No. ~~41702~~....  
 IN NAME OF

**HENRY W. AND/OR JEANETTE R. HEAD**

Surveyed April 6, 1982, by Bruce R. Sund.