


T. 36 S., R. 2 E., W. M.

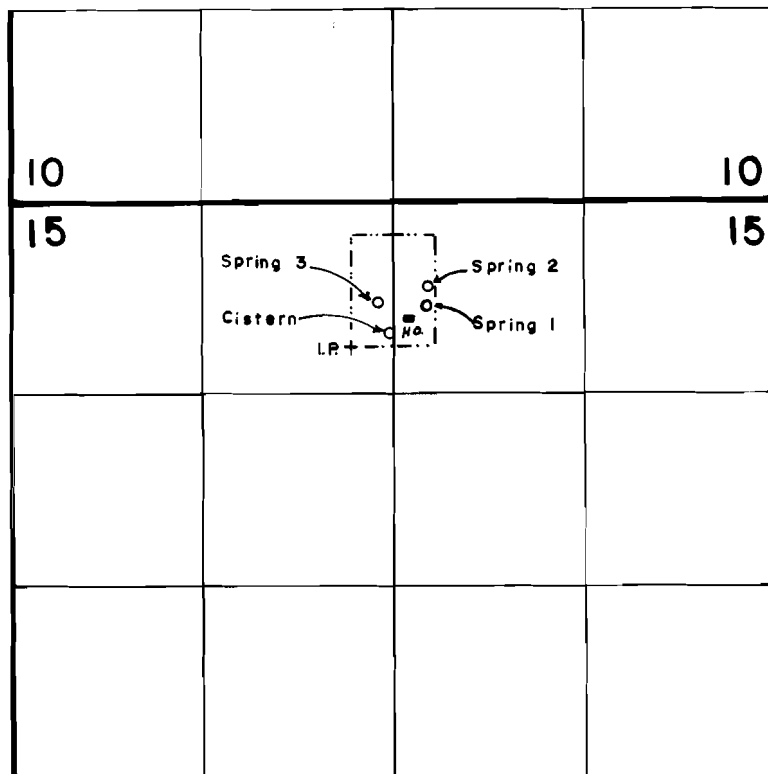

Spring Locations:

- 1- 720' S., 230' E;
- 2- 580' S., 240' E;
- 3- 690' S., 80' W; from N 1/4 corner, Sec. 15

FINAL PROOF SURVEY
UNDER

Application No. 56148 Permit No. 42144
IN NAME OF

VICTOR E. & HARRIET S. GARDENER

Surveyed O.C.T. 7, 1985, by B. S. JAMES.