



# T. 33 S., R. 2 E., W. M.

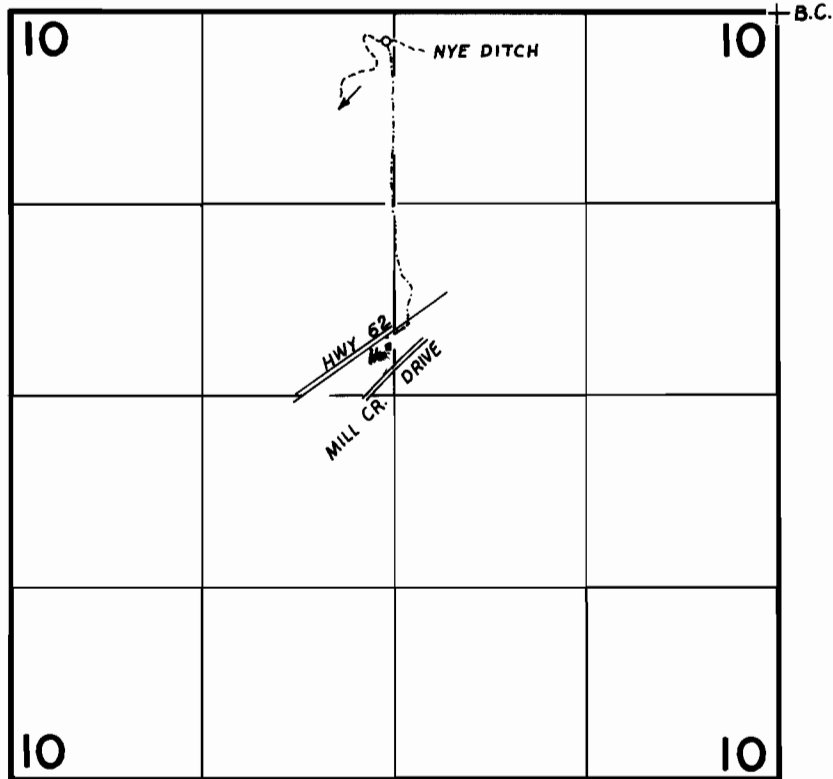

# T. 32 S., R. 3 E., W. M.

SCALE: 1" = 1320'

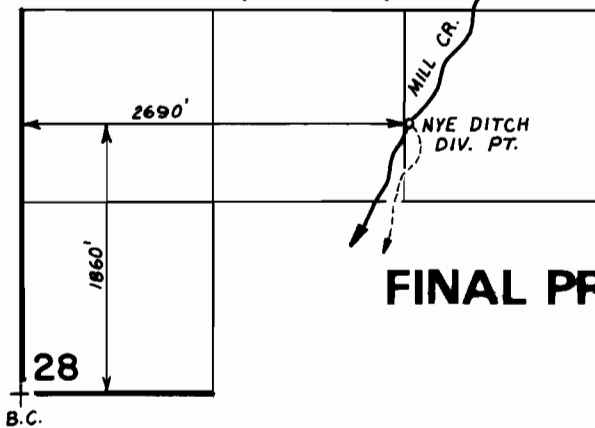

## FINAL PROOF SURVEY UNDER

Application No. **58803** Permit No. **44333**  
IN NAME OF

**LONNY W. &/or EDNA J. GALLAGHER**

Surveyed **JUNE 16, 1983**, by **B.S. JAMES**