


T.40 S., R.3 W., W.M.
SEC. 19

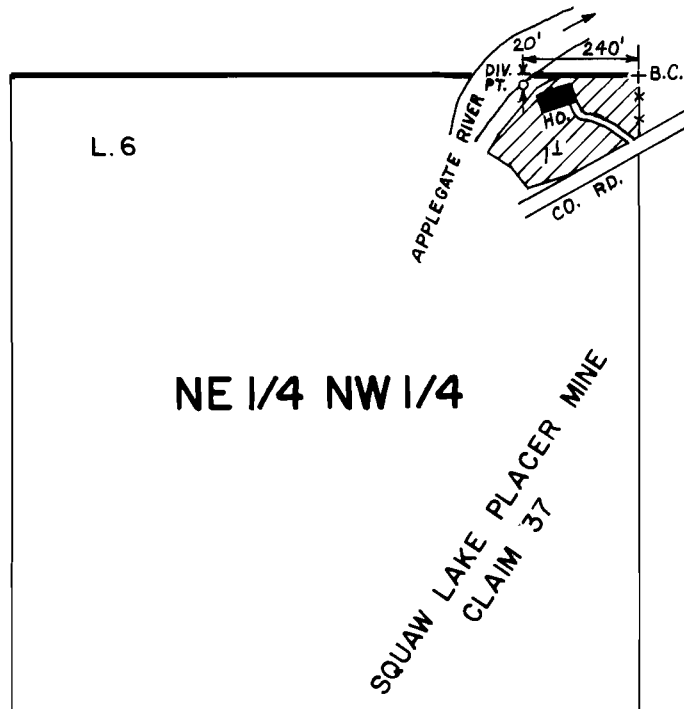

SCALE: 1" = 400'

FINAL PROOF SURVEY
UNDER

Application No. 62129 Permit No. 45959.....
IN NAME OF

HELMUT TROST &/or EMILY TROST.....

Surveyed JUNE 22 1982, by B. S. JAMES.....