


T.38S., R.4W., W.M.

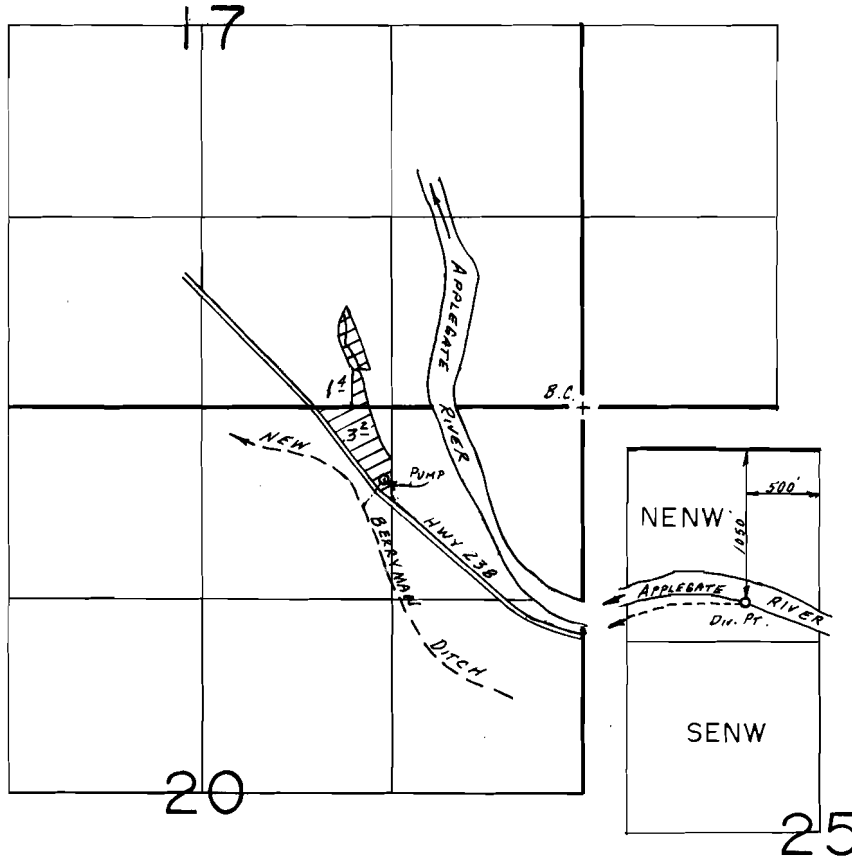

SCALE: 1"=1320'

**FINAL PROOF SURVEY**  
UNDER

Application No. 62132... Permit No. 45961.....

IN NAME OF

.....MERTON &/or NORMA J. SNOW.....

Surveyed Aug. 27. 19.85, by B.S. JAMES.....