


T. 36 S., R. 3 W., W. M.

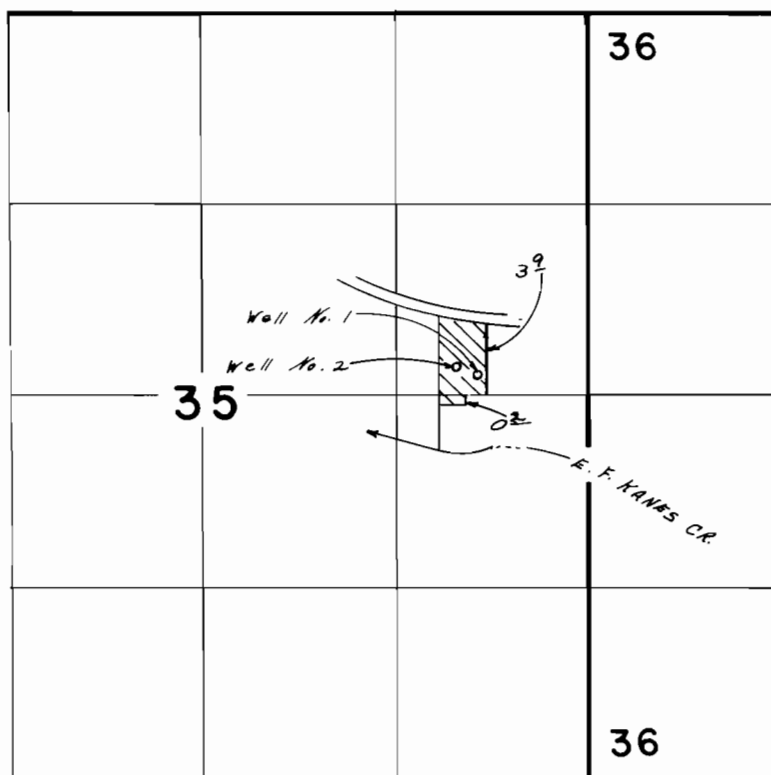

Well Locations:

No. 1: 150' N., 750' W.;

No. 2: 200' N., 900' W.;

Both from E 1/4 cor. SEC. 35

Scale: 1" = 1320'

FINAL PROOF SURVEY UNDER

Application No. G-10519 Permit No. G-9676
IN NAME OF

DUANE E. & OR VIOLET G. MACKEY

Surveyed JUN. 30 1986, by B. S. JAMES