


T. 38 S., R. 5 W., W. M.



CERTIFICATE
48458

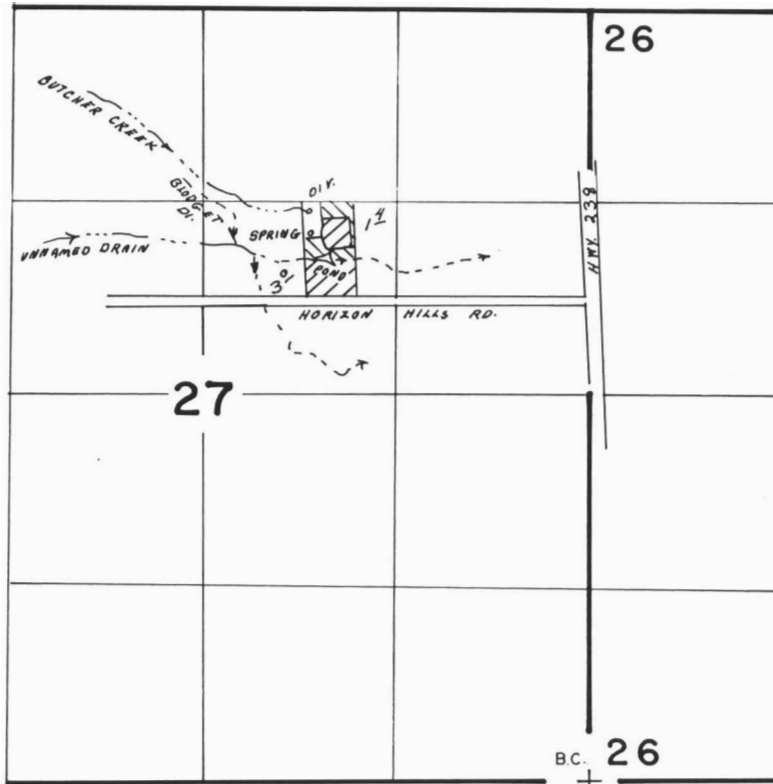

DIVERSIONS:

- BUTCHER CR. - 3900' N., 1950' W.;
 - SPRING - 3750' N., 1930' W.;
 - UNNAMED DRAIN - 3600' N., 1850' W.;
- ALL FROM SE CORNER SEC. 27

SCALE: 1" = 1320'

FINAL PROOF SURVEY

UNDER

R-53683

R-6502

53684

40779

Application No. 610.72 Permit No. 462.11.

IN NAME OF

EDWARD J. RATHMANN.

Surveyed AUG. 24. 19.85, by B.S. JAMES.....