


T.40S., R.9W., W.M.

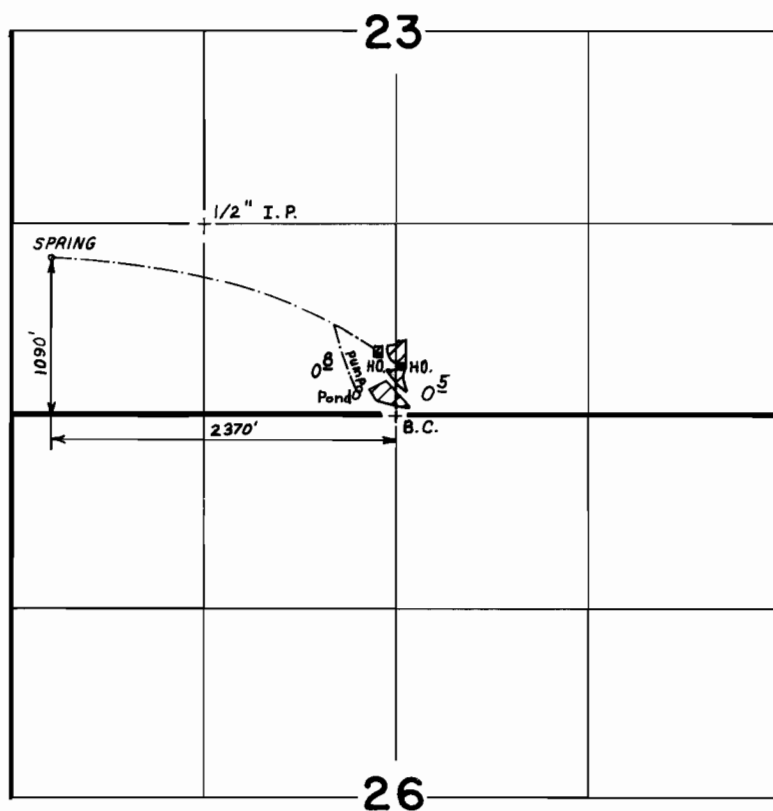

SCALE: 4" = 1 MILE

FINAL PROOF SURVEY
UNDER

Application No. 51315 Permit No. 37435
IN NAME OF

EDMOND C. BROWN

Surveyed AUG. 27 1982, by BRUCE R. SUND