
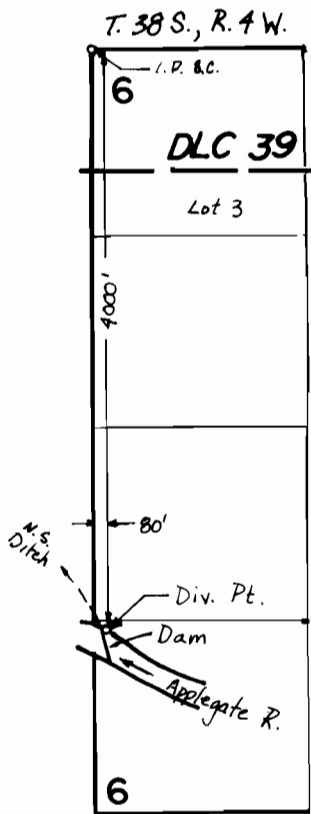


T. 37 S., R. 5 W., W.M.

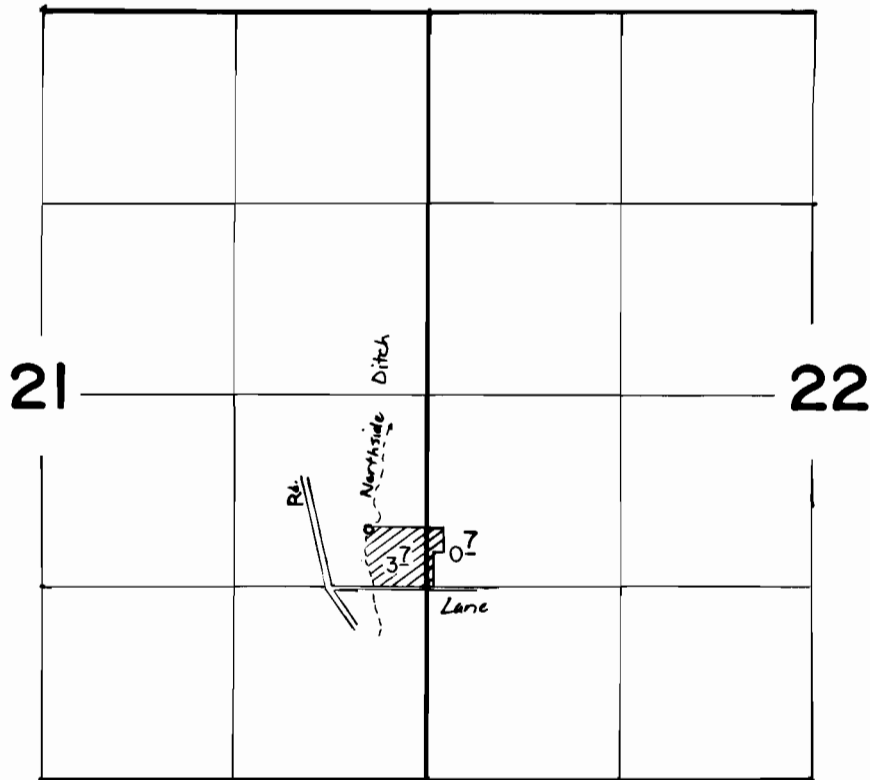

FINAL PROOF SURVEY UNDER

62119 46842
 Application No. 52042 Permit No. 39220
 IN NAME OF

BRUCE A. FAIN

Surveyed Aug. 18, 1983, by B. S. JAMES
 June 16, 1982, B. R. SUND